

NOTICE OF INTENTION TO DRILL

(see rules on reverse side)

Starting Date 6/26/86 month day year

API Number 15- 171-20,336 -00-00

OPERATOR: License # 5422
Name Abercrombie Drilling Inc.
Address 801 Union Center
City/State/Zip Wichita, KS 67202
Contact Person Jack Partridge
Phone 262-1841

W/2 NW NE. Sec. 22. Twp. 19S S. Rg. 31. 4620 Ft. from South Line of Section
2310 Ft. from East Line of Section

(Note: Locate well on Section Plat on reverse side)

CONTRACTOR: License # 5422
Name Abercrombie Drilling Inc.
City/State

Nearest lease or unit boundary line 330 feet
County Scott
Lease Name Stucky C Well # 1
Ground surface elevation 2956 est. feet MSL

Well Drilled For: Well Class: Type Equipment:
Oil SWD Infield Mud Rotary
Gas Inj Pool Ext Air Rotary
OWWO Expl Wildcat Cable

Domestic well within 330 feet: yes no
Municipal well within one mile: yes no
Surface pipe by Alternate: 1 2 X
Depth to bottom of fresh water 100'
Depth to bottom of usable water 1000 1400
Surface pipe planned to be set 250'
Projected Total Depth 4700' feet
Formation Mississippi

If OWWO: old well info as follows:

Operator
Well Name
Comp Date Old Total Depth

I certify that well will comply with K.S.A. 55-101, et seq., plus eventually plugging hole to KCC specifications.

cementing will be done immediately upon setting production casing.

Date 6-25-86 Signature of Operator or Agent Title Exec Vice President

For KCC Use:

Conductor Pipe Required feet; Minimum Surface Pipe Required 250 feet per Alt.


This Authorization Expires 12-26-86 Approved By 6-26-86

Must be filed with the K.C.C. five (5) days prior to commencing well
This card void if drilling not started within six (6) months of date received by K.C.C.

Important procedures to follow:

1. Notify District office before setting surface casing.
2. Set surface casing by circulating cement to the top.
3. File completion forms ACO-1 with K.C.C. within 90 days of well completion, following instructions on ACO-1, side 1, and including copies of wireline logs.
4. Notify District office 48 hours prior to old well workover or re-entry.
5. Prior to filing Intent, prepare a proposed plugging plan in case well is D & A, then obtain approval of plan when calling district office prior to setting surface pipe.
6. Submit plugging report (CP-4) to K.C.C. after plugging is completed.
7. Obtain an approved injection docket number before disposing of salt water.
8. Notify K.C.C. within 10 days when injection commences or terminates.
9. If an alternate 2 completion, cement in the production pipe from low any usable water to surface within 120 days of spud date.

A Regular Section of Land
1 Mile = 5,280 Ft.

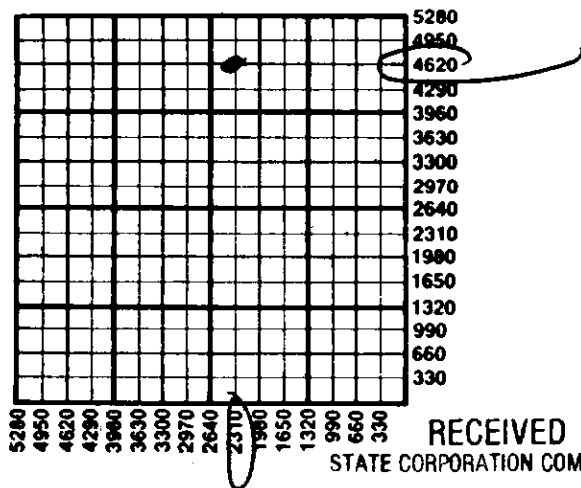

JUN 25 1986

CONSERVATION DIVISION
Wichita, Kansas

State Corporation Commission of Kansas
Conservation Division
200 Colorado Derby Building
Wichita, Kansas 67202
(316) 263-3238