

CARD MUST BE TYPED

State of Kansas
NOTICE OF INTENTION TO DRILL
(see rules on reverse side)

CARD MUST BE SIGNED

Starting Date: 7 8 85
month day year

API Number 15- 17/- 20, 299-00-00
 East

OPERATOR: License # 5886
Name Chief Drilling Co., Inc.
Address 905 Century Plaza
City/State/Zip Wichita, Kansas 67202
Contact Person Douglas W. Thimesch
Phone 316-262-3791

NE. SE. NW ... Sec 23.. Twp 17. S. Rge . 31 West
(location)
..... 3630 Ft North from Southeast Corner of Section
..... 2970 Ft West from Southeast Corner of Section
(Note: Locate well on Section Plat on reverse side)

CONTRACTOR: License # 5883
Name Warrior Drilling Co. Rig. #2
City/State Wichita Kansas 67202

Nearest lease or unit boundary line 330 feet.
County Scott
Lease Name SHARP Well# 1

Well Drilled For: Well Class: Type Equipment:
 Oil Swd Infield Mud Rotary
 Gas Inj Pool Ext. Air Rotary
 OWWO Expl Wildcat Cable

Domestic well within 330 feet: yes no
Municipal well within one mile: yes no

If OWWO: old well info as follows:
Operator
Well Name
Comp Date Old Total Depth
Projected Total Depth 4700 feet
Projected Formation at TD Miss
Expected Producing Formations LKC-Marm-Miss

Depth to Bottom of fresh water 100 175 feet
Lowest usable water formation Lower Cretaceous
Depth to Bottom of usable water 1300 feet
Surface pipe by Alternate: 1 2
Surface pipe to be set 250 feet
Conductor pipe if any required none feet
Ground surface elevation will provide feet MSI.
This Authorization Expires 1-3-86
Approved By 7-3-85 [Signature]

I certify that we will comply with K.S.A. 55-101, et seq., plus eventually plugging hole to K.C.C. specifications. production pipe will be cemented immediately

Date 7-3-85 Signature of Operator or Agent [Signature] Title
Douglas W. Thimesch

Vice President

Must be filed with the K.C.C. five (5) days prior to commencing well
This card void if drilling not started within six (6) months of date received by K.C.C.


RECEIVED
STATE CORPORATION COMMISSION

Important procedures to follow:

A Regular Section of Land
1 Mile = 5,280 Ft.

1111 03 1985
07-03-85
CONSERVATION DIVISION
Wichita, Kansas

1. Notify District office before setting surface casing.
2. Set surface casing by circulating cement to the top.
3. File completion forms ACO-1 with K.C.C. within 90 days of well completion, following instructions on ACO-1, side 1, and including copies of wireline logs.
4. Notify District office 48 hours prior to old well workover or re-entry.
5. Prior to plugging, prepare a plugging plan, then obtain agreement from the appropriate district office for an approved plugging plan.
6. Submit plugging report (CP-4) to K.C.C. after plugging is completed.
7. Obtain an approved injection docket number before disposing of salt water.
8. Notify K.C.C. within 10 days when injection commences or terminates.
9. If an alternate 2 completion, cement in the production pipe from below any usable water to surface within 120 days of spud date.

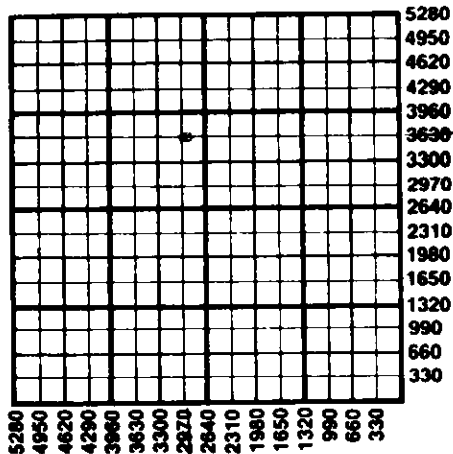

State Corporation Commission of Kansas
Conservation Division
200 Colorado Derby Building
Wichita, Kansas 67202
(316) 263-3238