

CARD MUST BE TYPED

State of Kansas  
NOTICE OF INTENTION TO DRILL

CARD MUST BE SIGNED

(see rules on reverse side)

Starting Date: 11 29 84  
month day year

API Number 15- 071-20,355-00-00

OPERATOR: License # 7271

C NW/4 Sec 33 Twp 20 S. Rge 39  East  West  
(location)

Name Bartling Oil Company  
Address 8550 Katy Freeway, #128  
City/State/Zip Houston, Texas 77024  
Contact Person Carl S. Graef  
Phone 713 465-1093

3960 Ft North from Southeast Corner of Section  
3960 Ft West from Southeast Corner of Section  
(Note: Locate well on Section Plat on reverse side)

CONTRACTOR: License # 6033  
Name Murfin Drilling Company  
City/State Wichita, Kansas

Nearest lease or unit boundary line 1320 feet.  
County Greeley  
Lease Name Klein Well# 2

Well Drilled For: Well Class: Type Equipment:  
 Oil  Swd  Infield  Mud Rotary  
 Gas  Inj  Pool Ext.  Air Rotary  
 OWWO  Expl  Wildcat  Cable

Domestic well within 330 feet:  yes  no  
Municipal well within one mile:  yes  no

If OWWO: old well info as follows:

Operator  
Well Name  
Comp Date Old Total Depth  
Projected Total Depth 3000 feet  
Projected Formation at ID Fort Riley  
Expected Producing Formations

Depth to Bottom of fresh water 250 feet  
Lowest usable water formation Cheyenne Dakota  
Depth to Bottom of usable water 1150 feet  
Surface pipe by Alternate:  1  2  
Surface pipe to be set 275 feet  
Conductor pipe if any required None feet  
Ground surface elevation 3512 feet MSI.  
This Authorization Expires 5-19-85  
Approved By 11-19-84 PC

I certify that we will comply with K.S.A. 55-101, et seq., plus eventually plugging hole to K.C.C. specifications.


Date 11/14/84 Signature of Operator or Agent

*Carl S. Graef*  
Title

GEOLOGIST  
MHC/KOHE 11/19/84

Must be filed with the K.C.C. five (5) days prior to commencing well  
This card void if drilling not started within six (6) months of date received by K.C.C.

**A Regular Section of Land**  
**1 Mile = 5,280 Ft.**

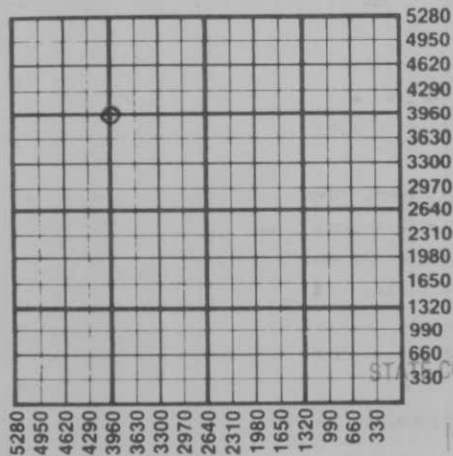

**Important procedures to follow :**

1. Notify District office before setting surface casing.
2. Set surface casing by circulating cement to the top.
3. File completion forms ACO-1 with K.C.C. within 90 days of well completion, following instructions on ACO-1, side I, and including copies of wireline logs.
4. Notify District office 48 hours prior to old well workover or re-entry.
5. Prior to plugging, prepare a plugging plan, then obtain agreement from the appropriate district office for an approved plugging plan.
6. Submit plugging report (CP-4) to K.C.C. after plugging is completed.
7. Obtain an approved injection docket number before disposing of salt water.
8. Notify K.C.C. within 10 days when injection commences or terminates.
9. If an alternate 2 completion, cement in the production pipe from below any usable water to surface within 120 days of spud date.

RECEIVED  
NOV 19 1984  
STATE CORPORATION COMMISSION  
CONSERVATION DIVISION  
Wichita, Kansas

State Corporation Commission of Kansas  
Conservation Division  
200 Colorado Derby Building  
Wichita, Kansas 67202  
(316) 263-3238