

CARD MUST BE TYPED

State of Kansas  
**NOTICE OF INTENTION TO DRILL**  
(see rules on reverse side)

CARD MUST BE SIGNED

Starting Date: 10-12-84  
month day year

API Number 15- 071-20,340-00-00

OPERATOR: License # 7271

C. SW SW SW/4 Sec 10 Twp 20 S, Rge 39  East  West  
(location)

Name Bartling Oil Co.

Address 8550 Katy Fwy # 128

City/State/Zip Houston, Tx 77024

Contact Person Carl S. Graef

Phone 713-465-1093

330 Ft North from Southeast Corner of Section  
4950 Ft West from Southeast Corner of Section  
(Note: Locate well on Section Plat on reverse side)

CONTRACTOR: License # 6033

Name Murfin Drilling

City/State 250 N. Oak, Wichita, KS

Well Drilled For: Well Class: Type Equipment:

Oil  Swd  Infield  Mud Rotary

Gas  Inj  Pool Ext.  Air Rotary

OWWO  Expl  Wildcat  Cable

If OWWO: old well info as follows:

Operator  
Well Name  
Comp Date Old Total Depth  
Projected Total Depth 3000 feet

Projected Formation at TD Ft. Riley

Expected Producing Formations

Nearest lease or unit boundary line 330 feet

County Greely

Lease Name Miller Well# 3

Domestic well within 330 feet:  yes  no

Municipal well within one mile:  yes  no

Depth to Bottom of fresh water 250 feet

Lowest usable water formation Cheyenne Dakota

Depth to Bottom of usable water 1150 1200 feet

Surface pipe by Alternate: 1  2  275 feet

Surface pipe to be set

Conductor pipe if any required

Ground surface elevation 3505 feet MSL

This Authorization Expires 4-12-85

I certify that we will comply with K.S.A. 55-101, et seq., plus eventually plugging hole to K.C.C. specifications.

Date 10-12-84 Signature of Operator or Agent


Susan Arnold Title as agent

Must be filed with the K.C.C. five (5) days prior to commencing well  
This card void if drilling not started within six (6) months of date received by K.C.C.

Wichita, Kansas  
CONSERVATION DIVISION

OCT 12 1984  
10-21-01

A Regular Section of Land STATE CORP. LAND  
1 Mile = 5,280 FA

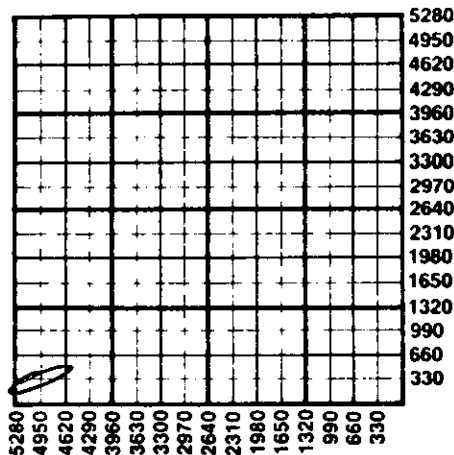

### Important procedures to follow :

1. Notify District office before setting surface casing.
2. Set surface casing by circulating cement to the top.
3. File completion forms ACO-1 with K.C.C. within 90 days of well completion, following instructions on ACO-1, side 1, and including copies of wireline logs.
4. Notify District office 48 hours prior to old well workover or re-entry.
5. Prior to plugging, prepare a plugging plan, then obtain agreement from the appropriate district office for an approved plugging plan.
6. Submit plugging report (CP-4) to K.C.C. after plugging is completed.
7. Obtain an approved injection docket number before disposing of salt water.
8. Notify K.C.C. within 10 days when injection commences or terminates.
9. If an alternate 2 completion, cement in the production pipe from below any usable water to surface within 120 days of spud date.

State Corporation Commission of Kansas  
Conservation Division  
200 Colorado Derby Building  
Wichita, Kansas 67202  
(316) 263-3238