

STATE OF KANSAS
STATE CORPORATION COMMISSION

Give All Information Completely
Make Required Affidavit
Mail or Deliver Report to:
Conservation Division
State Corporation Commission
211 No. Broadway
Wichita, Kansas


15-071-0002-00-00
WELL PLUGGING RECORD

Greely

County. Sec. 5 Twp. 20S Rge. 39W (E) (W)

Location as "NE/CNWxSWx" or footage from lines _____
Lease Owner Helmerich & Payne, Inc.
Lease Name Angell Well No. 1
Office Address Box 558, Garden City, Kansas
Character of Well (completed as Oil, Gas or Dry Hole) Dry Hole
Date well completed 6-26-63 19____
Application for plugging filed 6-26-63 19____
Application for plugging approved 6-26-63 19____
Plugging commenced 6-26-63 19____
Plugging completed 6-27-63 19____
Reason for abandonment of well or producing formation Dry Hole

NORTH

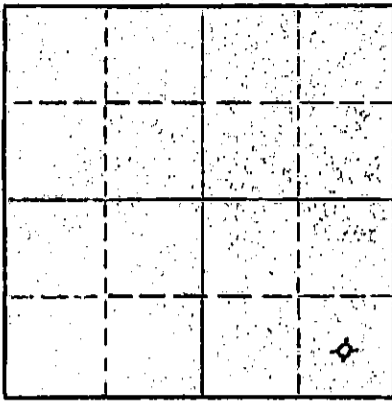

Locate well correctly on above
Section Plat

If a producing well is abandoned, date of last production _____ 19____
Was permission obtained from the Conservation Division or its agents before plugging was commenced? Yes

Name of Conservation Agent who supervised plugging of this well V. L. Nichols Moreland, Kansas
Producing formation _____ Depth to top _____ Bottom _____ Total Depth of Well 5381 Feet
Show depth and thickness of all water, oil and gas formations.

OIL, GAS OR WATER RECORDS

CASING RECORD

FORMATION	CONTENT	FROM	TO	SIZE	PUT IN	PULLED OUT
		325	0	13-3/8"	325	None

Describe in detail the manner in which the well was plugged, indicating where the mud fluid was placed and the method or methods used in introducing it into the hole. If cement or other plugs were used, state the character of same and depth placed, from _____ feet to _____ feet for each plug set.

5381 to 590' Heavy Rotary Mud
590 to 525' Plug & 20 sacks cement
525 to 320' Heavy Rotary Mud
320 to 270' Plug & 40 sacks cement
270 to 25' Heavy Rotary Mud
25 to 0 Plug & 20 sacks cement

PLUGGING COMPLETED AT 1:45 A.M., June 27, 1963

RECEIVED
STATE CORPORATION COMMISSION

JUN 28 1963

Name of Plugging Contractor Sierra Petroleum Co. Inc. (If additional description is necessary, use BACK of this sheet)
Address Petroleum Bldg, Wichita, Kansas

STATE OF Kansas COUNTY OF Finney, ss.
T. E. Mort (employee of owner) or (owner) of the above-described well, being first duly sworn on oath, says: That I have knowledge of the facts, statements, and matters herein contained and the log of the above-described well as filed and that the same are true and correct. So help me God.

(Signature) T. E. Mort

Box 558, Garden City, Kansas
(Address)

SUBSCRIBED AND SWORN TO before me this 27 day of June 19 63

My commission expires July 1964 Robert N. Boyd Notary Public.


INDEXED
DATE 6/28/63
INV. NO. 7328-10

Give All Information Completely
Make Required Affidavit
Mail or Deliver Report to:
Conservation Division
State Corporation Commission
311 No. Broadway
Wichita, Kansas

15-071-00022-00-80
WELL PLUGGING RECORD

GREENEY County, Sec. 5 Twp. 20S Rge. 39W (E) (W)

Location as "NE/CNW/SW" or footage from lines G SE SE
Lease Owner HELMERICH & PAYNE, INC.
Lease Name FRANCIS ANGELL Well No. 1
Office Address First National Building, Tulsa 3, Oklahoma
Character of Well (completed as Oil, Gas or Dry Hole) DRY HOLE
Date well completed June 24, 1963
Application for plugging filed June 26, 1963
Application for plugging approved June 26, 1963
Plugging commenced June 26, 1963
Plugging completed June 26, 1963
Reason for abandonment of well or producing formation DRY HOLE

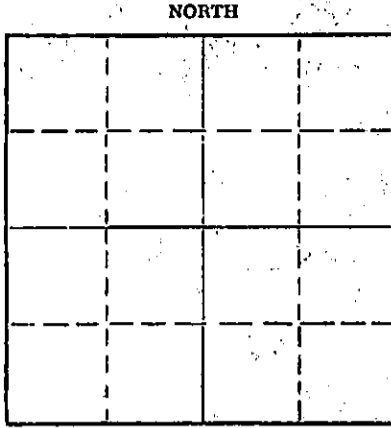

Locate well correctly on above Section Plat

If a producing well is abandoned, date of last production _____ 19____
Was permission obtained from the Conservation Division or its agents before plugging was commenced? YES

Name of Conservation Agent who supervised plugging of this well Mr. Eldon Petty, Hays, Kansas
Producing formation _____ Depth to top _____ Bottom _____ Total Depth of Well 5382 Feet
Show depth and thickness of all water, oil and gas formations.

OIL, GAS OR WATER RECORDS

CASING RECORD

FORMATION	CONTENT	FROM	TO	SIZE	PUT IN	PULLED OUT
Sand	SURFACE CASING	-0-	325'KB	13-3/8"	325'KB	NONE

Describe in detail the manner in which the well was plugged, indicating where the mud fluid was placed and the method or methods used in introducing it into the hole. If cement or other plugs were used, state the character of same and depth placed, from _____ feet to _____ feet for each plug set.

PLUGGED; Filled hole with heavy mud to 590'. Spotted 20 sx. cement through drill pipe. Filled hole with mud up to 320'. Spotted 1/4 sk. hulls, Globe Plug and 40 sx. cement through drill pipe. Filled hole with mud up to 25', spotted 1 sk. hulls, Globe Plug and 20 sx. cement to cellar zero.

Job completed 1:45 a.m., June 27, 1963.

RECEIVED
STATE CORPORATION COMMISSION

JUL 1 1963

CONSERVATION DIVISION
Wichita, Kansas

(If additional description is necessary, use BACK of this sheet)

Name of Plugging Contractor SIERRA PETROLEUM CO., INC.
Address 208 Petroleum Building, Wichita, Kansas

STATE OF KANSAS COUNTY OF RUSSELL, ss.
C. T. HONAKER, DRILLING SUPERINTENDENT (employee of owner) or (owner or operator) of the above-described well, being first duly sworn on oath, says: That I have knowledge of the facts, statements, and matters herein contained and the log of the above-described well as filed and that the same are true and correct. So help me God.

(Signature) C. T. Honaker C. T. HONAKER, DRILG. SUPT.

BOX 232, RUSSELL, KANSAS

(Address)

SUBSCRIBED AND SWORN to before me this 28TH day of JUNE, 1963

My commission expires 10-17-63

Lucy Dwyer
Notary Public.

15-071-00022-00-00

HELMERICH & PAYNE, INC. - Operator

SIERRA PETRO. CO., INC. - Contractor

FRANCIS ANGELL #1
C SE SE
Sec. 5-20S-39W
Greeley County, Kansas

T. D.: 5382'
Elev.: 3526' D.F.

Commenced: 6-3-63
Completed: 6-24-63

Casing:
13-3/8" New Casing Set at 325' K.B.

Cement:
with 300 sx. Quick Set

FORMATION	DEPTH
Sand	330
Shale	710
Shale & Shells	877
Sand	1130
Shale & Shells	1442
Anhydrite	1465
Red Bed & Shale	1731
Lime	1749
Red Bed & Lime	2075
Red Bed, Shale & Shells	2420
Anhydrite	2440
Red Bed	2486
Shale & Lime	2994
Lime	3080
Lime & Shale	4040
Lime	5045
Lime & Shale	5147
Lime	5382

RECEIVED
STATE CORPORATION COMMISSION

JUL 1 1963

CONSERVATION DIVISION
Wichita, Kansas

STATE OF KANSAS)
COUNTY OF RUSSELL) ss:

I hereby certify that the above information is true
and correct to the best of my knowledge.

A. T. Hanaker
Drilling Superintendent

Subscribed and sworn to before me this 28th day of June,
1963.

Leroy Diez
Notary Public

My Commission Expires: 10-17-63