


15-203-00003-00-00

Give All Information Completely
Make Required Affidavit
Mail or Deliver Report to:
Conservation Division
State Corporation Commission
211 No. Broadway
Wichita, Kansas

WELL PLUGGING RECORD

Wichita County, Sec. 23 Twp. 16S Rgs. 37 (W)
Location as "NE/CNW/SW" or footage from lines NW SE NE
Lease Owner Anadarko Production Company
Lease Name Pearson 1A-23 Well No. 1A-23
Office Address P. O. Box 351, Liberal, Kansas
Character of Well (completed as Oil, Gas or Dry Hole) Dry Hole
Date well completed August 13 19 60
Application for plugging filed August 24 19 60
Application for plugging approved August 12 (Per Mr. Broadfoot) 19 60
Plugging commenced August 13 19 60
Plugging completed August 13 19 60
Reason for abandonment of well or producing formation Dry Hole

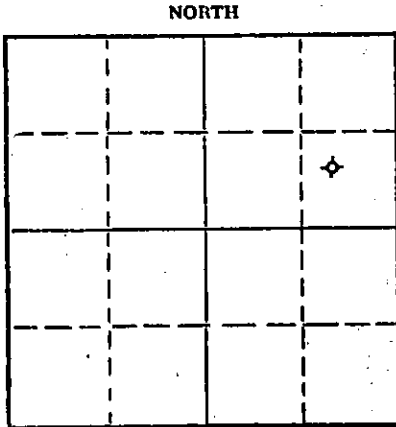

Locate well correctly on above
Section Plat

If a producing well is abandoned, date of last production 19
Was permission obtained from the Conservation Division or its agents before plugging was commenced? Yes

Name of Conservation Agent who supervised plugging of this well Mr. Frank Broadfoot
Producing formation _____ Depth to top _____ Bottom _____ Total Depth of Well 5730 Feet
Show depth and thickness of all water, oil and gas formations.

OIL, GAS OR WATER RECORDS

CASING RECORD

FORMATION	CONTENT	FROM	TO	SIZE	PUT IN	PULLED OUT
	NONE			13-3/8"	478'	None
				4-1/2"	4563'	2850'
				8-5/8"	2529'	728'

Describe in detail the manner in which the well was plugged, indicating where the mud fluid was placed and the method or methods used in introducing it into the hole. If cement or other plugs were used, state the character of same and depth placed, from _____ feet to _____ feet for each plug set.

Filled hole with mud from 4090 feet to 495 feet. Spotted 25 sacks cement from 495 feet to 470 feet. Filled with mud to surface. Spotted 5 sacks cement from 15 feet to surface.

RECEIVED
STATE CORPORATION COMMISSION

AUG 29 1960

CONSERVATION DIVISION
Wichita, Kansas

(If additional description is necessary, use BACK of this sheet)

Name of Plugging Contractor Andrews Well Servicing Company, Inc.
Address 811 North Roosevelt, Liberal, Kansas

STATE OF Kansas COUNTY OF Seward, ss.
I. R. L. O'Shields (employee of owner) or (owner or operator) of the above-described well, being first duly sworn on oath, says: That I have knowledge of the facts, statements, and matters herein contained and the log of the above-described well as filed and that the same are true and correct. So help me God.

(Signature) R. L. O'Shields R. L. O'Shields
Manager, Drilling and Production
P. O. Box 351, Liberal, Kansas
(Address)

SUBSCRIBED AND SWORN TO before me this 25th day of August, 1960

My Commission Expires
December 8, 1963

My commission expires _____

Robert F. Jackson
Notary Public.

15-203-00003-00-00

DRILLER'S LOG

WELL NAME: Pearson 1A-23;

COMPANY OPERATING: Anadarko Production Company
 ADDRESS of COMPANY: Box 351, Liberal, Kansas

WELL LOCATION: NW 1/4 SE 1/4 NE 1/4,
710 ft. North of South line, of NE/4
735 ft. East of West line; Sec. 23, Twp. 16S, Rge. 37W, Wichita County, Kansas

DRILLING STARTED June 29, 1960; DRILLING COMPLETED July 26, 1960
 WELL COMPLETED August 13, 1960; WELL CONNECTED _____, 19____

ELEVATION: 3326 ft. Ground Level; CHARACTER OF WELL (Oil, Gas, or Dry Hole) Dry Hole

OIL OR GAS SANDS OR ZONES - PERFORATIONS - ACIDIZING AND FRACTURING INFORMATION					
Name	From	To	No. of Shots	Gallons Used	Kind Used
				1000	15%
Marmaton	4468	4473	40	5000	10%
Marmaton	4494	4504	40	1000	15%

STATE OF KANSAS
 CORPORATIONS COMMISSION
 AUG 29 1960
 CONSERVATION DIVISION
 Wichita, Kansas

CASING RECORD

Size	Amount Set	Sacks of Cement	Amount Pulled
13-3/8"	478'	400	None
4-1/2"	4563'	150	2850'
8-5/8"	2529'	550	728'

FORMATION RECORD

Formation	Top	Bottom	Formation	Top	Bottom
Surface Sand	0	485'	Lime	3975	4086
Shale	485	1022	Shale, Chalk & Lime	4086	4237
Shale & Anhyd.	1022	1603	Shale & Lime	4237	4470
Anhyd., Shale & Salt	1603	1998	Lime	4470	4481
Salt & Shale	1998	2260	Lime & Chert	4481	4599
Shale	2260	2561	Lime & Shale	4599	4721
Sand & Shale	2561	3304	Chert & Lime	4721	4786
Anhyd. & Chert	3304	3361	Lime, Shale & Chert	4786	5133
Lime & Sand	3361	3434	Chert & Lime	5133	5371
Lime, Chert & Shale	3434	3660	Lime & Sand	5371	5601
Lime & Shale	3660	3752	Dolomite & Chert Strks	5601	5641
Lime, Shale & Chalk	3752	3853	Lime & Chert	5641	5730
Lime & Chert	3853	3975	Total Depth	5730	

RESULTS of INITIAL PRODUCTION TEST: