

15-203-19000-00-00

WELL PLUGGING RECORD

Give All Information Completely
Make Required Affidavit
Mail or Deliver Report to:
Conservation Division
State Corporation Commission
211 No. Broadway
Wichita, Kansas

Wichita County. Sec. 23 Twp. 16S. Rge. 37 X& (W)

Location as "NE/CNW&SW&" or footage from lines C SE NE

Lease Owner Anadarko Production Company

Lease Name Pearson Well No. 1-23

Office Address P. O. Box 351 Liberal, Kansas

Character of Well (completed as Oil, Gas or Dry Hole) Abandoned due to mechanical failure

Date well completed 19 60

Application for plugging filed July 1 19 60

Application for plugging approved June 28 19 60


Plugging commenced June 28 19 60

Plugging completed June 29 19 60

Reason for abandonment of well or producing formation Intermediate casing parted.

If a producing well is abandoned, date of last production 19

Was permission obtained from the Conservation Division or its agents before plugging was commenced? Yes

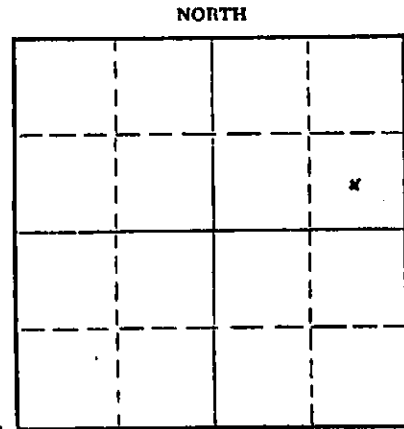

Locate well correctly on above Section Plat

Name of Conservation Agent who supervised plugging of this well Frank Broadfoot

Producing formation Depth to top Bottom Total Depth of Well 2980 Feet

Show depth and thickness of all water, oil and gas formations.

OIL, GAS OR WATER RECORDS

CASING RECORD

Table with 7 columns: FORMATION, CONTENT, FROM, TO, SIZE, PUT IN, PULLED OUT. Contains data for 13 3/8" and 8 5/8" casing sizes.

Describe in detail the manner in which the well was plugged, indicating where the mud fluid was placed and the method or methods used in introducing it into the hole. If cement or other plugs were used, state the character of same and depth placed, from feet to feet for each plug set.

Shot off 8 5/8" casing at 1020' and set 25 sacks of cement at 1020'.

Set 50 snoks cement and plug from 518' to 1,28'

RECEIVED STATE CORPORATION COMMISSION

JUL 14 1960

CONSERVATION DIVISION WICHITA, KANSAS

(If additional description is necessary, use BACK of this sheet)

Name of Plugging Contractor Moran Bros., Inc.

Address

STATE OF Kansas, COUNTY OF Seward, ss.

I, R. L. O'Shields (employee of owner) or (owner or operator) of the above-described well, being first duly sworn on oath, says: That I have knowledge of the facts, statements, and matters herein contained and the log of the above-described well as filed and that the same are true and correct. So help me God.

(Signature) R. L. O'Shields

P. O. Box 351, Liberal, Kansas (Address)

SUBSCRIBED AND SWORN TO before me this 10th day of July 1960

My Commission Expires December 8, 1963

My commission expires

Notary Public. [Signature]

15-203-19000-00-00
DRILLER'S LOG

WELL NAME: Pearson;

COMPANY OPERATING: Anadarko Production Company
 ADDRESS of COMPANY: Box 351, Liberal, Kansas

WELL LOCATION: C 1/4 SE 1/4 NE 1/4,
660 ft. North of South line,
660 ft. East of West line; Sec. 23, Twp. 16S, Rge. 37W, Wichita County, Kansas
 West East of NE/4

DRILLING STARTED June 19, 1960; DRILLING COMPLETED June 28, 1960
 WELL COMPLETED _____, 19____; WELL CONNECTED _____, 19____

ELEVATION: 3329.80 ft. Ground Level; CHARACTER OF WELL (Oil, Gas, or Dry Hole) Junked Hole

OIL OR GAS SANDS OR ZONES - PERFORATIONS - ACIDIZING AND FRACTURING INFORMATION					
Name	From	To	No. of Shots	Gallons Used	Kind Used
			NONE		

CASING RECORD

Size	Amount Set	Sacks of Cement	Amount Pulled
13-3/8"	177	100	None
8-5/8"	2503	100	1020'

FORMATION RECORD

Formation	Top	Bottom	Formation	Top	Bottom
Surface Sand	0	115			
Sand & Shale	115	191			
Red Bed & Sand	191	692			
Sand & Shale	692	1152			
Sand & Shale	1152	1442			
Sand & Shale	1442	1629			
Red Bed & Anhyd.	1629	2033			
Red Bed	2033	2141			
Red Bed	2141	2189			
Anhyd & Shale	2189	2518			
Red Bed & Anhyd.	2518	2964			
Anhyd & Shale	2964	2980			
Total Depth	2980				

RESULTS of INITIAL PRODUCTION TEST: _____