


STATE OF KANSAS
STATE CORPORATION COMMISSION

Give All Information Completely
Make Required Affidavit
Mail or Deliver Report to:
Conservation Division
State Corporation Commission
211 No. Broadway
Wichita, Kansas

WELL PLUGGING RECORD

NORTH

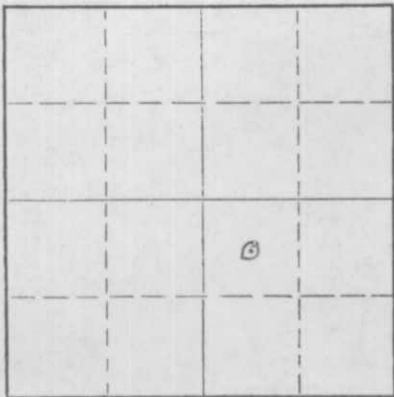

Locate well correctly on above
Section Plat

Wichita County. Sec. 32 Twp. 16S Rge. 38 (E) W (W)
Location as "NE/CNW/SW" or footage from lines C NW/4 SE/4
Lease Owner Phillips Petroleum Co.
Lease Name J. Bauck Well No. 1
Office Address Bartlesville, Okla.
Character of Well (completed as Oil, Gas or Dry Hole) Dry Hole
Date well completed 6-15 1959
Application for plugging filed 6-15 1959
Application for plugging approved By Phone 6-15 1959
Plugging commenced 2:30 PM 6-15 1959
Plugging completed 5:30 - 6-15 1959
Reason for abandonment of well or producing formation Dry Hole

If a producing well is abandoned, date of last production 19
Was permission obtained from the Conservation Division or its agents before plugging was commenced? Yes

Name of Conservation Agent who supervised plugging of this well Gilbert P. Hoeker
Producing formation _____ Depth to top _____ Bottom _____ Total Depth of Well 5338 Feet
Show depth and thickness of all water, oil and gas formations.

OIL, GAS OR WATER RECORDS

CASING RECORD

FORMATION	CONTENT	FROM	TO	SIZE	PUT IN	PULLED OUT
				230' - 8 5/8" casing		No

Describe in detail the manner in which the well was plugged, indicating where the mud fluid was placed and the method or methods used in introducing it into the hole. If cement or other plugs were used, state the character of same and depth placed, from _____ feet to _____ feet for each plug set.

Open end pipe was run into hole - pits were
gunked and Heavy Mud was pumped into hole.
20 Sacks of Cement placed 500' to 600 ft.
15 Sacks of Cement placed 180' to 220 ft
10 Sacks of Cement at Surface - Hulls on top
of plug at surface.

RECEIVED
STATE CORPORATION COMMISSION
JUL 20 1959
CONSERVATION DIVISION
Wichita, Kansas

Name of Plugging Contractor Haliburton
Address Hill City Kan

STATE OF _____, COUNTY OF _____, ss.

(employee of owner) or (owner or operator) of the above-described well, being first duly sworn on oath, says: That I have knowledge of the facts, statements, and matters herein contained and the log of the above-described well as filed and that the same are true and correct. So help me God.

(Signature) J. H. Smith
Coward Kansas
(Address)

SUBSCRIBED AND SWORN TO before me this 18th day of July, 1959
Thelma M. Knudson
Notary Public.

My commission expires June 18 1960

PLUGGING
FILE SEC. 32 T. 16 R. 38 W
BOOK PAGE 57 LINE 18

15-203-00008-00-00

WELL PLUGGING RECORD


Give All Information Completely
Make Required Affidavit
Mail or Deliver Report to:
Conservation Division
State Corporation Commission
211 No. Broadway
Wichita, Kansas

Wichita

County. Sec. 32 Twp. 16 Rge. 38 (E) W (W)

Location as "NE/CNW $\frac{1}{4}$ SW $\frac{1}{4}$ " or footage from lines C NW SE
Lease Owner Phillips Petroleum Company
Lease Name J. BAUCK Well No. 1
Office Address Battlesville, Oklahoma
Character of Well (completed as Oil, Gas or Dry Hole) Dry Hole
Date well completed 6-15-59 19
Application for plugging filed 6-15-59 19
Application for plugging approved 6-15-59 19
Plugging commenced 6-15-59 19
Plugging completed 6-15-59 19
Reason for abandonment of well or producing formation Dry Hole

NORTH

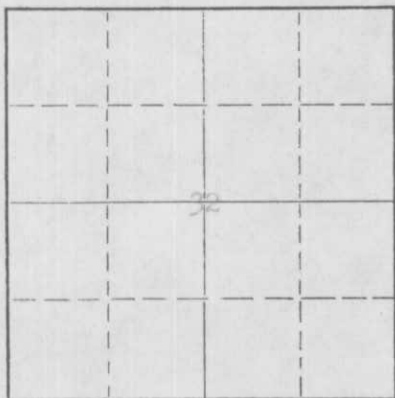

Locate well correctly on above Section Plat

If a producing well is abandoned, date of last production _____ 19____
Was permission obtained from the Conservation Division or its agents before plugging was commenced? Yes

Name of Conservation Agent who supervised plugging of this well Gilbert P. Keizer
Producing formation _____ Depth to top _____ Bottom _____ Total Depth of Well 5338 Feet
Show depth and thickness of all water, oil and gas formations.

OIL, GAS OR WATER RECORDS

CASING RECORD

FORMATION	CONTENT	FROM	TO	SIZE	PUT IN	PULLED OUT

Describe in detail the manner in which the well was plugged, indicating where the mud fluid was placed and the method or methods used in introducing it into the hole. If cement or other plugs were used, state the character of same and depth placed, from _____ feet to _____ feet for each plug set.

Fits were gunned and heavy mud was pumped into the well then plugged as follows;
Twenty sacks were placed from 600 ft. to 510 ft.
Fifteen sacks were placed from 220 Ft. to 180 Ft.
Ten sacks were placed from 25 ft. to surface.

RECEIVED
STATE CORPORATION COMMISSION
OCT 23 1959
CONSERVATION DIVISION
Wichita, Kansas

(If additional description is necessary, use BACK of this sheet)

Name of Plugging Contractor Halliburton Oil Well Cementing Co.
Address Hill City, Kansas

STATE OF _____, COUNTY OF _____, ss.
_____(employee of owner) or (owner or operator) of the above-described well, being first duly sworn on oath, says: That I have knowledge of the facts, statements, and matters herein contained and the log of the above-described well as filed and that the same are true and correct. So help me God

(Signature) [Signature]
Rd. Box 10 Thermopolis, Wyo
(Address)

SUBSCRIBED AND SWORN TO before me this 21 day of October, 1959
[Signature]
Notary Public.

My commission expires _____



United States Commissioner
My Term Expires March 10, 1963