

15-203-00015-00-00

WELL PLUGGING RECORD

Give All Information Completely
Make Required Affidavit
Mail or Deliver Report to:
Conservation Division
State Corporation Commission
211 No. Broadway
Wichita, Kansas

Wichita

County. Sec. 16 Twp. 17 Rge. 37 (E) (W)

Location as "NE/CNW/SW" or footage from lines. C NW NW

Lease Owner Panhandle Eastern Pipe Line Co.

Lease Name Nelson Well No. 01

Office Address Box 351

Character of Well (completed as Oil, Gas or Dry Hole) Oil

Date well completed Sept. 11 19 57

Application for plugging filed August 24 19 59

Application for plugging approved August 24 19 59


Plugging commenced August 25 19 59

Plugging completed August 27 19 59

Reason for abandonment of well or producing formation Would not produce in commercial quantities.

If a producing well is abandoned, date of last production August 2 19 58

Was permission obtained from the Conservation Division or its agents before plugging was commenced? Yes

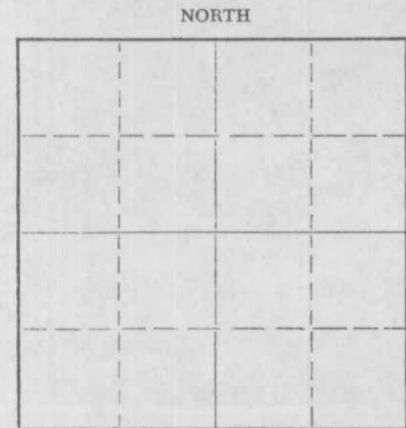

Locate well correctly on above Section Plat

Name of Conservation Agent who supervised plugging of this well Mr. G. Leiker

Producing formation Marmaton Depth to top 4502' Bottom 4613' Total Depth of Well 4617' Feet

Show depth and thickness of all water, oil and gas formations.

OIL, GAS OR WATER RECORDS

CASING RECORD

FORMATION	CONTENT	FROM	TO	SIZE	PUT IN	PULLED OUT
Wab.		2540	3797	8-5/8"	549'	left in
Top.		3797	4007	4-1/2"	4607'	indicated below
Heeb.		4007	4023			
Tor.		4023	4097			
Lans.		4097	4502			
Marm.		4502	4613			
Cher.		4613				

Describe in detail the manner in which the well was plugged, indicating where the mud fluid was placed and the method or methods used in introducing it into the hole. If cement or other plugs were used, state the character of same and depth placed, from _____ feet to _____ feet for each plug set.

4-1/2" set at 4607' with 250 sacks + 355 gallons of sealment. Perf. at 4520'. Pumped in 20 sacks on top of cement at 4445' by Halliburton Cementing Company. Shot off at 2835'. Pulled up to 560', Pumped in 20 sacks cement. Pulled up to 210', Pumped in 20 sacks of cement. Filled 8-5/8" casing with mud within 40' of top. Put in 10' of Rock Bridge then cemented to top with 10 sacks of cement. 8-5/8" casing cut off 5' below ground level and capped.

This plugging was witnessed by state plugger of Kansas, Mr. G. Leiker, Victoria, Kansas.

RECEIVED
STATE CORPORATION COMMISSION

SEP 2 1959

CONSERVATION DIVISION
Wichita, Kansas

(If additional description is necessary, use BACK of this sheet)

Name of Plugging Contractor Daco Well Service

Address Borger, Texas

STATE OF Kansas, COUNTY OF Seward, ss.

Panhandle Eastern Pipe Line Co. (employee of owner) or (owner or operator) of the above-described well, being first duly sworn on oath, says: That I have knowledge of the facts, statements, and matters herein contained and the log of the above-described well as filed and that the same are true and correct. So help me God.

(Signature) S. G. Neitheroat

(Address)

SUBSCRIBED AND SWORN TO before me this 31st day of August, 19 59

S. G. Blair

Notary Public.

MY COMMISSION EXPIRES DEC. 9, 1961

My commission expires _____

PLUGGING
FILE SEC 16 T 17 R 37W
BOOK PAGE 62 LINE 42

15-203-00015-00-00

DRILLER'S LOG

WELL NAME: **WLS N #1-16** WELL LOCATION: _____ ft. _____ of _____ line,
and _____ ft. _____ of _____ line, (C 11 W) Sec. 16, Twp. 17S, Rge. 37W,
Wichita County, Kansas. Elevation: 3362 ft. G.L.

COMPANY: Panhandle Eastern Pipe Line Company, Box #979, Liberal, Kansas
CONTRACTOR: **Musgrove Petroleum Corporation, 801 Union Center Bldg., Wichita, Kansas**

DRILLING COMMENCED: 7/18/57
DRILLING COMPLETED: 8/22/57
WELL COMPLETED: 10-10-57
WELL CONNECTED:

PRODUCTION INFORMATION:
SOURCE OF DATA: Driller's Reports

ROTARY LOG

Description of Formation	Top	Bottom	FORMATIONS	Tops
Line	5155	5770	Wabaunsee	2540
Sand & Line	5770	5865	Topeka	3797
Line	5865	5977	Heebner	4007
Sand	5977	6000 TD	Toronto	4023
			Lansing	4097
			Marraton	4502
			Cherokee	4613
			Morrow Shale	4831
			Morrow Sand	4860
			Mississippian	4930
			Viola	5485
			Arbuckle	5668
			Regan Sand	5960

*Producing Formation(s)

PERFORATIONS:

- 4528-4532
- 4503-4509
- 4532-4528

WELL TREATMENT RECORD:

- A/2000 gals 15% - 8/8/57
- A/500 gals MA - 8/27/57
- A/500 gals NA - 8/30/57
- A/1000 gals HA - 9/6/57

RECEIVED
STATE CORPORATION COMMISSION
APR 9 1968
CONSERVATION DIVISION
Wichita, Kansas

file
15-203-00015-00-00

CONTRACTOR'S WELL LOG

COMPANY:	Panhandle Eastern Pipe Line Co.
CONTRACTOR:	Musgrove Petroleum Corporation
FARM:	NELSON #1
LOCATION:	C NW NW, Sec. 16-17S-37W Wichita County, Kansas
COMMENCED:	July 18, 1957
COMPLETED:	August 22, 1957

Musgrove Petroleum Corporation drilled this well from 0' to 5155', then it was taken over by Panhandle Eastern Pipe Line Co.

RECEIVED
STATE CORPORATION COMMISSION
APR 9 1968
CONSERVATION DIVISION
Wichita, Kansas

5155	5770	Lime
5770	5865	Sand & lime
5865	5977	Lime
5977	6000	Sand
	6000	Rotary Total Depth

Set 8-5/8" surface casing at 549' w/275 sx Posmix, 2% calcium chloride.

Set 4-1/2" casing at 4607' w/240 sx common cement, 2% calcium chloride, and 355 gallons Sealment.

STATE OF KANSAS)
) SS
COUNTY OF SEDGWICK)

I, Emil E. Bowers, do hereby certify that the above and foregoing is a true and correct copy of the log of the NELSON #1, C NW NW, Section 16-17S-37W, Wichita County, Kansas, as reflected by the files of the Musgrove Petroleum Corporation.

MUSGROVE PETROLEUM CORPORATION

BY Emil E. Bowers
Secretary-Treasurer

Subscribed and sworn to before me, a Notary Public, in and for Sedgwick County, Kansas, this 26th day of August, 1957.

NOTARY PUBLIC
AUG 28 1957
RECEIVED

Leah Jane Heys
Notary Public

My commission expires June 16, 1959.