


Give All Information Completely
Make Required Affidavit
Mail or Deliver Report to:
Conservation Division
State Corporation Commission
800 Bitting Building
Wichita, Kansas

15-203-00009-00-00

WELL PLUGGING RECORD

WICHITA County, Sec. 12 Twp. 17 Rge. 37 (E) W (W)
SW 1/4, SW 1/4, SW 1/4

Location as "NE/CNW/SW" or footage from lines _____
Lease Owner Rooney-Seigfried-Thomas
Lease Name D. Lindberg Well No. 1
Office Address Box 324---Great Bend, Kansas
Character of Well (completed as Oil, Gas or Dry Hole) Dry Hole
Date well completed 12-1-53 19____
Application for plugging filed 12-1-53 19____
Application for plugging approved 12-1-53 19____
Plugging commenced 12-1-53 19____
Plugging completed 12-1-53 19____
Reason for abandonment of well or producing formation Dry Hole

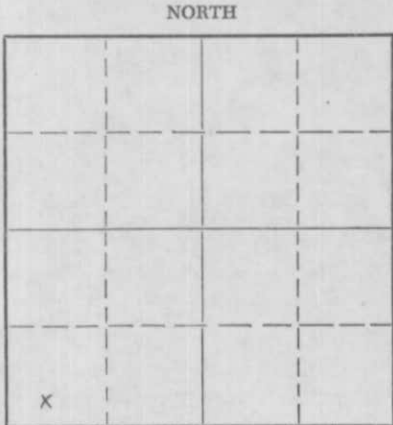

Locate well correctly on above Section Plat

If a producing well is abandoned, date of last production _____ 19____
Was permission obtained from the Conservation Division or its agents before plugging was commenced? Yes

Name of Conservation Agent who supervised plugging of this well C. D. Stough
Producing formation _____ Depth to top _____ Bottom _____ Total Depth of Well 4981 Feet
Show depth and thickness of all water, oil and gas formations.

OIL, GAS OR WATER RECORDS

CASING RECORD

FORMATION	CONTENT	FROM	TO	SIZE	PUT IN	PULLED OUT
Heebner	Marker	3948		10-3/4"	271	None
Toronto	Dry	3964				
Douglas	Marker	3989				
Lansing-Kansas City	Dry	3996				
BKC		4392				
Marmaton	Dry	4392				
Morrow	Dry	4845				
Mississippi	Dry	4877	4981			

Describe in detail the manner in which the well was plugged, indicating where the mud fluid was placed and the method or methods used in introducing it into the hole. If cement or other plugs were used, state the character of same and depth placed, from _____ feet to _____ feet for each plug set.

Hole was filled with heavy mud to 260 feet and plug was set. 25 sacks of cement were then hand mixed and poured through the drill pipe on top of the plug.
Hole was then filled to 40 feet and plug was set. 10 sacks of cement were then hand mixed and put on top of the plug.

RECEIVED
STATE CORPORATION COMMISSION
DEC 24 1953
CONSERVATION DIVISION
240


(If additional description is necessary, use BACK of this sheet)
Name of Plugging Contractor SCHAFFER DRILLING COMPANY
Address BOX 350 PRATT, KANSAS

STATE OF KANSAS, COUNTY OF PRATT, SS.
J. E. Selby (employee of owner) or (owner or operator) of the above-described well, being first duly sworn on oath, says: That I have knowledge of the facts, statements, and matters herein contained and the log of the above-described well as filed and that the same are true and correct. So help me God.

(Signature) J. E. Selby
Pratt, Kansas
(Address)

SUBSCRIBED AND SWORN TO before me this 14 day of December, 1953.

My commission expires February 25, 1956
Hilda Lauter Notary Public.

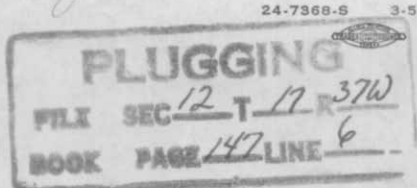

15-203-00009-00-06

DRILLER'S LOG
Lindberg #1
Wichita County, Kansas

ROONEY-SEIGFRIED & THOMAS

COMMENCED November 14, 1953
COMPLETED December 1, 1953.

0-120	Surface clay, sand & shale
120-190	Sand
190-268	Blue Shale
268-1021	Shale & Shells
1021-1125	Sandy Shale
1125-1211	Sand
1211-1245	River Gravel
1245-1405	Shale & Sand
1405-1590	Shale, Shells & Red Bed
1590-1750	Shale & Shells
1750-1790	Shale & Red Bed
1790-1820	Anhydrite
1820-2440	Shale, Shells & Red Bed
2440-2470	Anhydrite
2470-2495	Shale, Red Bed & Salt
2495-2650	Red Bed & Shells
2650-2700	Shale & Red Bed
2700-2730	Shale & Lime Shells
2730-2965	Shale, Lime & Red Rock
2965-3235	Shale & Shells
3235-3300	Shale, Lime & Red Rock
3300-3465	Shale & Lime
3465-3535	Lime
3535-3845	Shale & Lime
3845-4415	Lime
4415-4682	Shale & Lime
4682-4713	Lime, Chert & Shale
4713-4870	Shale & Lime
4870-4885	Shale & Sand
4885-4981	Shale & Lime
4981	TOTAL DEPTH

I certify that the above is true and correct as being taken from the daily drilling reports of the LINDBERG #1.

PLUGGING

J. E. Selby
 J. E. Selby--Bookkeeper
 SCHAFFER DRILLING COMPANY

STATE OF KANSAS, COUNTY OF PRATT, SS:
Subscribed and sworn to before me this 4th day of December 1953.

Linda Coulter
 Notary Public

My commission expires February 25, 1956.