


Give All Information Completely
Make Required Affidavit
Mail or Deliver Report to:
Conservation Division
State Corporation Commission
211 No. Broadway
Wichita, Kansas

15-203-00017-00-00
WELL PLUGGING RECORD

NORTH

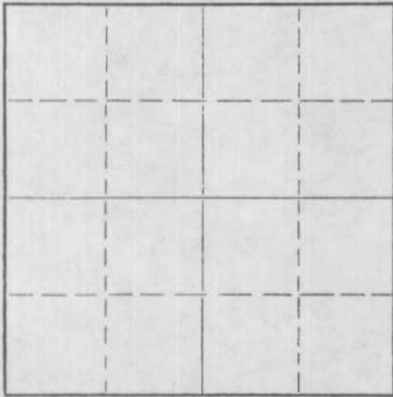

Locate well correctly on above
Section Plat

Wichita County. Sec. 12 Twp. 17 Rge. (E) 38 (W)
Location as "NE/CNW/SW" or footage from lines C NW/4
Lease Owner Musgrove Petroleum Corporation
Lease Name LANGLEY Well No. 1
Office Address 801 Union Center, Wichita, Kansas
Character of Well (completed as Oil, Gas or Dry Hole) Dry hole
Date well completed November 5 19 56
Application for plugging filed verbally November 4 19 56
Application for plugging approved verbally November 4 19 56
Plugging commenced November 5 19 56
Plugging completed November 5 19 56
Reason for abandonment of well or producing formation Dry

If a producing well is abandoned, date of last production 19
Was permission obtained from the Conservation Division or its agents before plugging was commenced? verbally - yes

Name of Conservation Agent who supervised plugging of this well R. M. Brundege
Producing formation _____ Depth to top _____ Bottom _____ Total Depth of Well 5165 Feet
Show depth and thickness of all water, oil and gas formations.

OIL, GAS OR WATER RECORDS

CASING RECORD

FORMATION	CONTENT	FROM	TO	SIZE	PUT IN	PULLED OUT
				8-5/8"	560'	

Describe in detail the manner in which the well was plugged, indicating where the mud fluid was placed and the method or methods used in introducing it into the hole. If cement or other plugs were used, state the character of same and depth placed, from _____ feet to _____ feet for each plug set.

Filled hole with mud to 540'
1st Plug set at 540' w/20 sx cement.
Filled hole with mud to 40'
2nd Plug set at 40' w/10 sx cement
Job completed 10:30 P.M. 11-5-56

(If additional description is necessary, use BACK of this sheet)
Name of Plugging Contractor Musgrove Petroleum Corporation
Address 801 Union Center, Wichita, Kansas

STATE OF Kansas, COUNTY OF Sedgwick
I, Gordon L. Koelling (employee of owner) or (owner or operator) of the above-described well, being first duly sworn on oath, says: That I have knowledge of the facts, statements, and matters herein contained and the log of the above-described well as filed and that the same are true and correct. So help me God.

(Signature) Gordon L. Koelling
801 Union Center, Wichita, Kansas
(Address)

SUBSCRIBED AND SWORN TO before me this 19th day of November, 19 56

Leah Joyce Hepler
Notary Public.

My commission expires June 16, 1959

RECEIVED
NOV 20 1956
11-20-56
CONSERVATION DIVISION
Wichita, Kansas

PLUGGING
FILE SEC 12 T 17 R 38W
BOOK PAGE 114 LINE 17

15-203-00017-00-00

CONTRACTOR'S WELL LOG

COMPANY: Musgrove Petroleum Corporation
 CONTRACTOR: Musgrove Petroleum Corporation
 FARM: LANGLEY #1
 LOCATION: C NW/4 Sec. 12-17-38W
 Wichita County, Kansas
 COMMENCED: September 29, 1956
 COMPLETED: November 5, 1956

	0	145	Surface soil & clay
	145	1020	Shale
	1020	1230	Sand
	1230	1441	Shale & shells
	1441	1560	Shale
	1560	1815	Red bed
	1815	1860	Lime & shale
	1860	2170	Shale
	2170	2500	Shale & lime shells
	2500	2525	Lime & anhydrite
	2525	2736	Lime & shale
	2736	2814	Shale & sand
	2814	3150	Lime & shale
	3150	3254	Shale & lime streaks
	3254	3330	Lime & shale
WHIPSTOCK:			
	1765	1825	Sandy lime & shale
	1825	2500	Shale & lime
	2500	2516	Lime
	2516	3268	Shale & lime
	3268	3442	Lime
	3442	3496	Lime & chert
	3496	3590	Lime & shale
	3590	3650	Lime
	3650	3672	Lime & sand
	3672	4855	Lime
	4855	4921	Lime & shale
	4921	4986	Lime & sand
	4986	5165	Lime
		5165	Rotary Total Depth

Set 8-5/8" surface pipe at 560' with 250 sacks Posmix, 3% calcium chloride.
 DRY AND ABANDONED

ELEVATION:	3331' K. B.	Heebner	3971' (- 640)
TOPS: (Schlumberger)		Lansing	4065' (- 734)
Anhydrite	2497'	Marmaton	4436' (-1105)
Wabaunsee	3582' (-251)	Morrow Shale	4827' (-1496)
Topeka	3774' (-443)	Mississippi	4959' (-1625)

STATE OF KANSAS)
) SS
 COUNTY OF SEDGWICK)

I, GORDON L. KOELLING, do hereby certify that the above and foregoing is a true and correct copy of the log of the LANGLEY #1, C NW/4, Sec. 12-17-38W, Wichita County, Kansas, as reflected by the files of the Musgrove Petroleum Corporation.

MUSGROVE PETROLEUM CORPORATION

By Gordon L. Koelling
 Secretary-Treasurer

Subscribed and sworn to before me, a Notary Public, in and for Sedgwick County, Kansas, this 19th day of November, 1956.

Dean Jaye Wolfe
 Notary Public

My commission expires June 16, 1959.

PLUGGING
 FILE NO. 12-17 R 38W
 BOOK PAGE 114 LINE 17