

STATE OF KANSAS
STATE CORPORATION COMMISSION

15-203-00014-00-00
WELL PLUGGING RECORD

Give All Information Completely
Make Required Affidavit
Mail or Deliver Report to:
Conservation Division
State Corporation Commission
211 No. Broadway
Wichita, Kansas

Wichita County, Sec. 18 Twp. 18 Rge. (E) 35 (W)

Location as "NE/CNW%SW%" or footage from lines NW/4 of NE/4

Lease Owner Benedum-Trees Oil Company

Lease Name Knobbe No.1 Well No. 1

Office Address 1142 Milam Building, San Antonio 5, Texas

Character of Well (completed as Oil, Gas or Dry Hole) Dry Hole

Date well completed February 1, 19 57

Application for plugging filed 19

Application for plugging approved 19


Plugging commenced February 1, 19 57

Plugging completed February 1, 19 57

Reason for abandonment of well or producing formation Dry Hole

If a producing well is abandoned, date of last production 19

Was permission obtained from the Conservation Division or its agents before plugging was commenced?

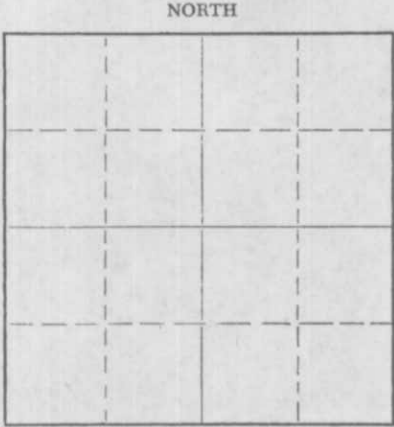

Locate well correctly on above Section Plat

Name of Conservation Agent who supervised plugging of this well

Producing formation Depth to top Bottom Total Depth of Well 5120 Feet

Show depth and thickness of all water, oil and gas formations.

OIL, GAS OR WATER RECORDS

CASING RECORD

FORMATION	CONTENT	FROM	TO	SIZE	PUT IN	PULLED OUT

Describe in detail the manner in which the well was plugged, indicating where the mud fluid was placed and the method or methods used in introducing it into the hole. If cement or other plugs were used, state the character of same and depth placed, from feet to feet for each plug set.

Mud to 510'
First Plug at 510' 25 sacks cement
Mud to 60'
Second Plug at 60' - 25 sacks cement to top of hole

(If additional description is necessary, use BACK of this sheet)

Name of Plugging Contractor McKnab & Lindsay, plugged with Rotary Rig.

Address 1117 Millington, Winfield, Kansas

STATE OF Kansas, COUNTY OF Cowley, ss.

V. W. McKnab (employee of owner) or (owner or operator) of the above-described well, being first duly sworn on oath, says: That I have knowledge of the facts, statements, and matters herein contained and the log of the above-described well as filed and that the same are true and correct. So help me God.

(Signature) V. W. McKnab

1117 Millington, Winfield, Kansas

(Address)

SUBSCRIBED AND SWORN TO before me this 4th day of February, 1957

My commission expires August 21, 1957

Notary Public.

PLUGGING
FILE SEC 18 T 18 R 35W
BOOK PAGE 138 LINE 34

RECEIVED
CORPORATION COMMISSION
FEB - 5 1957
02-05-57
CONSERVATION DIVISION
Wichita, Kansas

15-203-00014-00-00

WELL RECORD

KNOBBE NO. 1
C NW NE, Sec. 18-18S-35W
Wichita County, Kansas

Owner: Benedum-Trees Oil Company
Contractor: McKnab and Lindsay

Date Comm: 1-10-57
Under Surface: 1-13-57
Date Comp: 2-1-57

Driller's Log:

Sand & Gravel	0	250
Sand & Shale	250	1670
Lime & Shale	1670	2168
Shale, Lime & Sand	2168	2440
Anyhdrite	2440	2465
Shale & Lime	2465	2960
Shale	2960	3075
Lime	3075	3250
Shale & Chalky Lime	3250	3293
Lime & Chert	3293	3424
Cherty Lime	3424	3457
Lime	3457	3528
Lime & Shale	3528	3700
Lime	3700	4658
Lime & Chert	4658	4685
Lime & Shale	4685	4747
Lime	4747	4775
Lime & Chert	4775	4840
Sand & Lime	4840	4952
Sand	4952	4958
Miss. Lime	4958	5120
T.D.		5120

Casing Record

531' of 10-3/4" Surface Casing cemented with 450 sacks Halliburton Oil Well cement, 2 Calcium Clarite.

Plugged at 510' with 25 sacks cement. Second Plug at 60' with 25 sacks cement to plug top of hole.

D & A

APPROVED:
McKnab and Lindsay, Contractors

By _____

Date _____

Subscribed to and sworn before me this _____ day of _____, 19____

My Commission Expires August 21, 1957

RECEIVED
STATE CORPORATION COMMISSION

Notary Public

PLUGGING
FILE SEC <u>18</u> T. <u>18</u> R. <u>35W</u>
BOOK PAGE <u>138</u> LINE <u>34</u>

FEB - 5 1957

CONSERVATION DIVISION
Wichita, Kansas