

KANSAS CORPORATION COMMISSION OF KANSAS
OIL & GAS CONSERVATION DIVISION
WELL COMPLETION OR RECOMPLETION FORM
ACO-1 WELL HISTORY
DESCRIPTION OF WELL AND LEASE

Operator: License # 5171
Name TXO Production Corp.
Address 1800 Lincoln Center Bldg.
1660 Lincoln Street
City/State/Zip Denver, Colorado 80264

Purchaser Permian Corp.
Tulsa, Oklahoma

Operator Contact Person Frank D. Tsuru
Phone (303) 861-4246

Contractor: License # 6633
Name Murfin Drilling Co., Inc.

Wellsite Geologist Richard Bacon
Phone

Designate Type of Completion
 New Well Re-Entry Workover
 Oil SWD Temp Abd
 Gas Inj Delayed Comp.
 Dry Other (Core, Water Supply etc.)

If OMWO: old well info as follows:
Operator
Well Name
Comp. Date
Old Total Depth

WELL HISTORY


Drilling Method:
 Mud Rotary Air Rotary Cable
9/21/85 9/28/85 10/14/85
Spud Date Date Reached TD Completion Date
5300' 5261'
Total Depth PBD

Amount of Surface Pipe Set and Cemented at 385 feet
Multiple Stage Cementing Collar Used? Yes No
If yes, show depth set 2772 feet
If alternate 2 completion, cement circulated from 2772 feet depth to surface / 350 SX cmt
Cement Company Name
Invoice #

API NO. 15-~~071-20893-0000~~
County Greeley
NE SE NE Sec. 1 Twp 16S Rge. 43 East
..... West
3630 Ft North from Southeast Corner of Section
330 Ft West from Southeast Corner of Section
(Note: Locate well in section plat below)

Lease Name Edsall Well # F-8
Field Name S.W. Stockholm
Producing Formation Lower Morrow
Elevation: Ground 3868 KB 3873

Section Plat

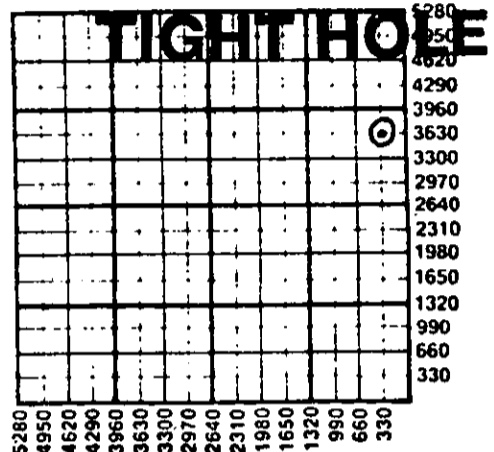

WATER SUPPLY INFORMATION

Disposition of Produced Water: Disposal
Docket # Repressuring

Questions on this portion of the ACO-1 call:

Water Resources Board (913) 296-3717

Source of Water:
Division of Water Resources Permit #
 Groundwater.....Ft North from Southeast Corner
(Well)Ft West from Southeast Corner of
Sec Twp Rge East West
 Surface Water.....Ft North from Southeast Corner
(Stream, pond etc).....Ft West from Southeast Corner
Sec Twp Rge East West
 Other (explain)
(purchased from city, R.W.D. #)

INSTRUCTIONS: This form shall be completed in duplicate and filed with the Kansas Corporation Commission, 200 Colorado Derby Building, Wichita, Kansas 67202, within 90 days after completion or recompletion of any well. Rule 82-3-130 and 82-3-107 apply. Information on side two of this form will be held confidential for a period of 12 months if requested in writing and submitted with the form. See rule 82-3-107 for confidentiality in excess of 12 months. One copy of all wireline logs and drillers time log shall be attached with this form. Submit CP-4 form with all plugged wells. Submit CP-111 form with all temporarily abandoned wells.

All requirements of the statutes, rules and regulations promulgated to regulate the oil and gas industry have been fully complied with and the statements herein are complete and correct to the best of my knowledge.

Signature Frank D. Tsuru
Title Drlg. & Production Engineer Date 11/12/85

Subscribed and sworn to before me this 19th day of November
1985
Notary Public Sharon A. Beyers

Date Commission Expires My Commission expires October 10, 1988

K.C.C. OFFICE USE ONLY
 Letter of Confidentiality Attached
 Wireline Log Received
 Drillers Time Log Received
Distribution
 KCC SWD/Rep NGPA
 KGS Plug Other
(Specify)

KANSAS CORPORATION COMMISSION OF KANSAS
OIL & GAS CONSERVATION DIVISION
WELL COMPLETION OR RECOMPLETION FORM
ACO-1 WELL HISTORY
DESCRIPTION OF WELL AND LEASE

Operator: License # 5171
Name TXO Production Corp.
Address 1800 Lincoln Center Bldg.
1660 Lincoln Street
City/State/Zip Denver, Colorado 80264

Purchaser Permian Corp.
Tulsa, Oklahoma

Operator Contact Person Frank D. Tsuru
Phone (303) 861-4246

Contractor: License # 6033
Name Murfin Drilling Co., Inc.

Wellsite Geologist Richard Bacon
Phone

Designate Type of Completion
 New Well Re-Entry Workover
 Oil SWD Temp Abd
 Gas Inj Delayed Comp.
 Dry Other (Core, Water Supply etc.)

If OMWO: old well info as follows:
Operator
Well Name
Comp. Date Old Total Depth

WELL HISTORY

Drilling Method:
 Mud Rotary Air Rotary Cable
9/21/85 9/28/85 10/14/85
Spud Date Date Reached TD Completion Date
5300' 5261'
Total Depth PBTD

Amount of Surface Pipe Set and Cemented at 385 feet
Multiple Stage Cementing Collar Used? Yes No
If yes, show depth set 2772 feet
If alternate 2 completion, cement circulated
from 2772 feet depth to surface / 350 SX cmt
Cement Company Name
Invoice #

API NO. 15-071-20893-00-00

County Greeley

NE SE NE Sec. 1 Twp 16S Rge. 43 East West

3630 Ft North from Southeast Corner of Section
330 Ft West from Southeast Corner of Section
(Note: Locate well in section plat below)


Lease Name Edsall Well # F-8

Field Name S.W. Stockholm

Producing Formation Lower Morrow

Elevation: Ground 3868 KB 3873

Section Plat

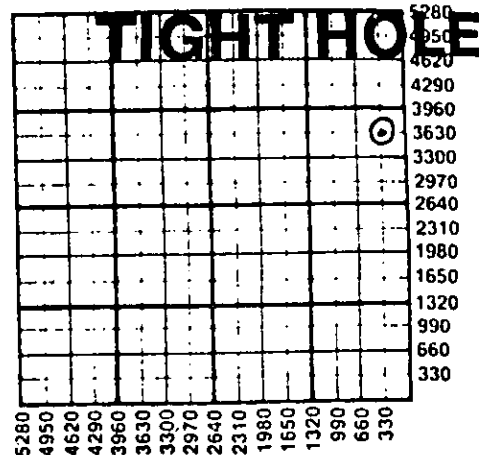

WATER SUPPLY INFORMATION

Disposition of Produced Water: Disposal
Docket # Repressuring

Questions on this portion of the ACO-1 call:

Water Resources Board (913) 296-3717

Source of Water:
Division of Water Resources Permit #

Groundwater.....Ft North from Southeast Corner
(Well)Ft West from Southeast Corner of
Sec Twp Rge East West

Surface Water.....Ft North from Southeast Corner
(Stream, pond etc).....Ft West from Southeast Corner
Sec Twp Rge East West

Other (explain).....
(purchased from city, R.W.D. #)

INSTRUCTIONS: This form shall be completed in duplicate and filed with the Kansas Corporation Commission, 200 Colorado Derby Building, Wichita, Kansas 67202, within 90 days after completion or recompletion of any well. Rule 82-3-130 and 82-3-107 apply. Information on side two of this form will be held confidential for a period of 12 months if requested in writing and submitted with the form. See rule 82-3-107 for confidentiality in excess of 12 months. One copy of all wireline logs and drillers time log shall be attached with this form. Submit CP-4 form with all plugged wells. Submit CP-111 form with all temporarily abandoned wells.

All requirements of the statutes, rules and regulations promulgated to regulate the oil and gas industry have been fully complied with and the statements herein are complete and correct to the best of my knowledge.

Signature Frank D. Tsuru
Title Drig. & Production Engineer Date 11/12/85

Subscribed and sworn to before me this 19th day of November 1985
Notary Public Sharon O. Reyes
Date Commission Expires October 10, 1988

K.C.C. OFFICE USE ONLY
 Letter of Confidentiality Attached
 Wireline Log Received
 Drillers Timelog Received
Distribution
KCC SWD/Rap NGPA
KGS Plug Other
(Specify)

NOV 21 1985
11-02-1985