

To: 1 051164 API NUMBER 15-171-20,383-00-00  
STATE CORPORATION COMMISSION  
CONSERVATION DIVISION - PLUGGING SECTION W/2 W/2 SE, SEC. 27, T 17 S, R 31 W/E  
200 COLORADO DERBY BUILDING  
WICHITA, KANSAS 67202

TECHNICIAN'S PLUGGING REPORT  
Operator License # 3988 Lease Name Gruver "O" Well # 1  
1320 feet from S section line  
2310 feet from E section line

Operator: Slawson Exploration Company, Inc. County Scott  
Name & Address 104 South Broadway  
Wichita, KS 67202  
Well Total Depth 4590 feet  
Conductor Pipe: Size \_\_\_\_\_ feet  
Surface Casing: Size 8 5/8 feet 350

Abandoned Oil Well \_\_\_\_\_ Gas Well \_\_\_\_\_ Input Well \_\_\_\_\_ SWD Well \_\_\_\_\_ D&A X  
Other well as hereinafter indicated \_\_\_\_\_

Plugging Contractor L.D. Drilling, Inc. License Number 6039  
Address Box 183 B, Great Bend, KS 67530

Company to plug at: Hour: 1:30 a.m. Day: 26 Month: 4 Year: 19 89

Plugging proposal received from Greg Davidson  
(company name) L.D. Drilling, Inc. (phone) 316-793-3051

were: to fill hole with heavy mud and spot cement through drill pipe Elevation 2921'  
Anhydrite 2270-88'  
1st plug at 2280' with 50 sx cement, 2nd plug at 1400' with 80 sx cement,  
3rd plug at 380' with 50 sx cement,  
4th plug at 40' with 10 sx cement,  
5th plug to circulate rathole with 15 sx cement.

Plugging Proposal Received by Richard W. Lacey  
(TECHNICIAN)

Plugging Operations attended by Agent?: All \_\_\_\_\_ Part \_\_\_\_\_ None X  
Operations Completed: Hour: 7:30 a.m. Day: 26 Month: 4 Year: 19 89

ACTUAL PLUGGING REPORT 1st plug at 2280' with 50 sx cement,  
2nd plug at 1400' with 80 sx cement,  
3rd plug at 380' with 50 sx cement,  
4th plug at 40' with 10 sx cement,  
5th plug to circulate rathole with 15 sx cement.

Remarks: Used 60/40 Pozmix 6% gel by Allied.  
(If additional description is necessary, use BACK of this form.)

~~INVOICED~~  
I (did/did not) observe this plugging.  
DATE 5-3-89 Signed Richard W. Lacey  
24585 (TECHNICIAN)

RECEIVED  
STATE CORPORATION COMMISSION  
APR 27 1989  
04-27-89  
CONSERVATION DIVISION  
Wichita, Kansas

Must be approved by the K.C.C. five (5) days prior to commencing well

Expected Spud Date April 11 1989  
month day year

W/2. W/2. SE. Sec 27. Twp 17. S, Rg 31. X East West

OPERATOR: License # 3988  
Name: SLAWSON EXPLORATION COMPANY, INC.  
Address: 104 S. Broadway  
City/State/Zip: Wichita, Kansas 67202  
Contact Person: Jim Reusberg  
Phone: (316) 263-3201

1320' feet from South line of Section  
2310' feet from East line of Section  
(Note: Locate well on Section Plat Below)

CONTRACTOR: License #: 6039  
Name: L.D. Drilling, Inc.

County: Scott  
Lease Name: Gruver "0" Well #: #1  
Field Name: Wildcat  
Is this a Prorated field? yes X no  
Target Formation(s): Mississippian  
Nearest lease or unit boundary: 330'  
Ground Surface Elevation: 2921' GR feet MSL  
Domestic well within 330 feet: yes X no  
Municipal well within one mile: yes X no  
Depth to bottom of fresh water: 180'  
Depth to bottom of usable water: 1350'  
Surface Pipe by Alternate: 1 X 2  
Length of Surface Pipe Planned to be set: 350'  
Length of Conductor pipe required: None  
Projected Total Depth: 4600'  
Formation at Total Depth: Mississippian  
Water Source for Drilling Operations: Irr. Well  
... well ... farm pond X other  
DWR Permit #: 109-26  
Will Cores Be Taken?: yes X no  
If yes, proposed zone:

Well Drilled For: Well Class: Type Equipment:  
X Oil Inj Infield X Mud Rotary  
Gas Storage Pool Ext. Air Rotary  
OWO Disposal X Wildcat Cable  
Seismic: # of Holes


If OWO: old well information as follows:  
Operator:  
Well Name:  
Comp. Date: Old Total Depth

Directional, Deviated or Horizontal wellbore? yes X no  
If yes, total depth location:

Spud 4-17-89 - Sect 350' 8 1/2" 200' Act 2 Reg.

PUSHER 4590 FORMATION  
TD 4600  
SURFACE PIPE 8 7/8 @ 350  
ANHYDRITE 2270-83 ELEVATION 2921  
STARTING TIME & DATE 4-25-89 1:30  
COMPLETION TIME & DATE 4-26-89 7:30 AM  
1st PLUG @ 2250 FT. W/ 50 SX  
2nd PLUG @ 1400 FT. W/ 80 SX  
3rd PLUG @ 380 FT. W/ 50 SX  
4th PLUG @ 40 FT. W/ 10 SX  
RAT HOLE CIRCULATED W/ 15 SX  
MOUSE HOLE CIRCULATED W/ SX  
WATER WELL PLUGGED W/ SX  
CEMENT COMPANY  
TECHNICIAN

RECEIVED  
STATE CORPORATION COMMISSION  
APR 27 1989  
CONSERVATION DIVISION  
Wichita, Kansas

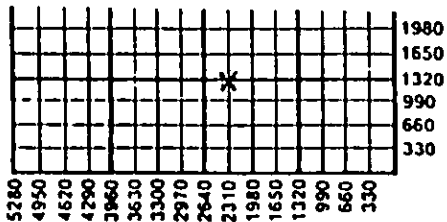

IN APR 0 1989 Spud date: Agent:

- REMEMBER TO:  
- File Drill Pit Application (form CDP-1) with Intent to Drill;  
- File Completion Form ACO-1 within 120 days of spud date;  
- File acreage attribution plat according to field proration orders;  
- Notify appropriate district office 48 hours prior to workover or re-entry;  
- Submit plugging report (CP-4) after plugging is completed;  
- Obtain written approval before disposing or injecting salt water.