

CARD MUST BE TYPED

State of Kansas
NOTICE OF INTENTION TO DRILL
(see rules on reverse side)

CARD MUST BE SIGNED

Starting Date: June 1, 1985
month day year

API Number 15- 171-20, 296-00-00

OPERATOR: License # 6528
Name R. J. Patrick Operating Company
Address P. O. Box 1314
City/State/Zip Liberal, Kansas 68901
Contact Person R. J. Patrick
Phone 316-624-8483

SW SW_{1/4} SW_{1/4} Sec 1 Twp 18 S, Rge 33
(location) East West

CONTRACTOR: License # 6666
Name NRG Drilling, Inc
City/State Liberal, Kansas 67901

330 Ft North from Southeast Corner of Section
4950 Ft West from Southeast Corner of Section
(Note: Locate well on Section Plat on reverse side)

Well Drilled For: Well Class: Type Equipment:
 Oil Swd Infield Mud Rotary
 Gas Inj Pool Ext. Air Rotary
 OWWO Expl Wildcat Cable

Nearest lease or unit boundary line 330 feet.
County Scott

Lease Name Melson Well# 1-1

Domestic well within 330 feet: yes no

Municipal well within one mile: yes no

If OWWO: old well info as follows:

Operator
Well Name
Comp Date Old Total Depth
Projected Total Depth 4800 feet
Projected Formation at TD Mississippi
Expected Producing Formations Lansing & Morrow

Depth to Bottom of fresh water 1300 feet

Lowest usable water formation Cheyenne

Depth to Bottom of usable water 1500 feet

Surface pipe by Alternate: 1 2

Surface pipe to be set 1500 feet

Conductor pipe if any required 30 feet

Ground surface elevation 2971 feet MSL

This Authorization Expires 11-29-85

Approved By 5-29-85 *[Signature]*

I certify that we will comply with K.S.A. 55-101, et seq., plus eventually plugging hole to K.C.C. specifications.

Date 5-23-85 Signature of Operator or Agent

Mary Morgan

Title Office Manager


MHC/MOHE 5-29-85

RECEIVED
STATE CORPORATION COMMISSION

MAY 29 1985

CONSERVATION DIVISION
Wichita, Kansas

A Regular Section of Land
1 Mile = 5,280 Ft.

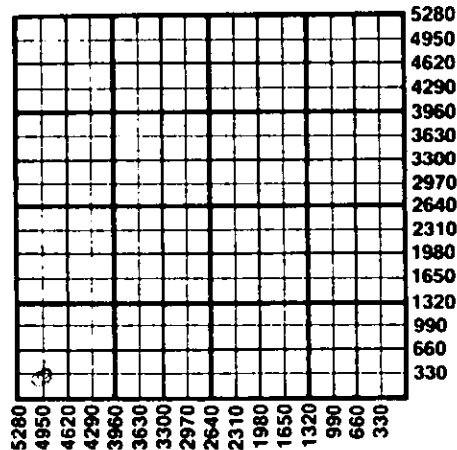

Must be filed with the K.C.C. five (5) days prior to commencing well
This card void if drilling not started within six (6) months of date received by K.C.C.

Important procedures to follow :

1. Notify District office before setting surface casing.
2. Set surface casing by circulating cement to the top.
3. File completion forms ACO-1 with K.C.C. within 90 days of well completion, following instructions on ACO-1, side 1, and including copies of wireline logs.
4. Notify District office 48 hours prior to old well workover or re-entry.
5. Prior to plugging, prepare a plugging plan, then obtain agreement from the appropriate district office for an approved plugging plan.
6. Submit plugging report (CP-4) to K.C.C. after plugging is completed.
7. Obtain an approved injection docket number before disposing of salt water.
8. Notify K.C.C. within 10 days when injection commences or terminates.
9. If an alternate 2 completion, cement in the production pipe from below any usable water to surface within 120 days of spud date.

State Corporation Commission of Kansas
Conservation Division
200 Colorado Derby Building
Wichita, Kansas 67202
(316) 263-3238