

CARD MUST BE TYPED

State of Kansas
NOTICE OF INTENTION TO DRILL

CARD MUST BE SIGNED

(see rules on reverse side)

Starting Date: ...2/15/86.....
month day year

API Number 15- 171-20,324-00-00
C SE SE Sec 5... Twp 19 S, Rge 53...
(location) East West

OPERATOR: License #5692.....
Name FINA OIL & CHEMICAL COMPANY.....
Address ...1601 N.W. Expressway Ste. 900.....
City/State/Zip Oklahoma City, OK 73118.....
Contact Person Joe Springer.....
Phone (405) 840-0671.....

.....560..... Ft North from Southeast Corner of Section
.....650..... Ft West from Southeast Corner of Section
(Note: Locate well on Section Plat on reverse side)

CONTRACTOR: License #Unknown.....
Name
City/State

Nearest lease or unit boundary line530..... feet.
County Scott.....
Lease Name Hunter..... Well # i.....
Domestic well within 330 feet: yes no
Municipal well within one mile: yes no

Well Drilled For: Well Class: Type Equipment:
 Oil Swd Infield Mud Rotary
 Gas Inj Pool Ext. Air Rotary
 OWWO Expl Wildcat Cable

Depth to Bottom of fresh water200..... feet
Lowest usable water formationDakota.....
Depth to Bottom of usable water1150..... feet
Surface pipe by Alternate: 1 2
Surface pipe to be set350..... feet
Conductor pipe if any required feet
Ground surface elevation2977' KB..... feet MSL

If OWWO: old well info as follows:
Operator
Well Name
Comp Date Old Total Depth
Projected Total Depth4800..... feet
Projected Formation at TDMississippi.....
Expected Producing Formations Miss. Morrow.....

This Authorization Expires ~~8-4-86~~ 8-4-86
Approved By2-4-86.....
R


I certify that we will comply with K.S.A. 55-101, et seq., plus eventually plugging hole to K.C.C. specifications.

Date 2/13/86..... Signature of Operator or Agent *Raylene Smith* Title Production Tech.....
R
R

Must be filed with the K.C.C. five (5) days prior to commencing well
This card void if drilling not started within six (6) months of date received by K.C.C.

REC'D
MAY 8 1988
02-04-88
REGISTRATION DIVISION

A Regular Section of Land
1 Mile = 5,280 Ft.

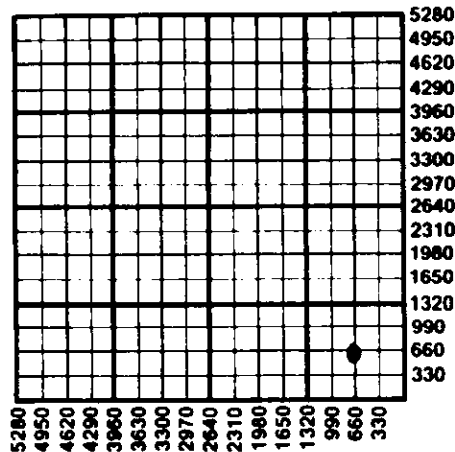

Important procedures to follow :

1. Notify District office before setting surface casing.
2. Set surface casing by circulating cement to the top.
3. File completion forms ACO-1 with K.C.C. within 90 days of well completion, following instructions on ACO-1, side 1, and including copies of wireline logs.
4. Notify District office 48 hours prior to old well workover or re-entry.
5. Prior to plugging, prepare a plugging plan, then obtain agreement from the appropriate district office for an approved plugging plan.
6. Submit plugging report (CP-4) to K.C.C. after plugging is completed.
7. Obtain an approved injection docket number before disposing of salt water.
8. Notify K.C.C. within 10 days when injection commences or terminates.
9. If an alternate 2 completion, cement in the production pipe from below any usable water to surface within 120 days of spud date.

State Corporation Commission of Kansas
Conservation Division
200 Colorado Derby Building
Wichita, Kansas 67202
(316) 263-3238