

EFFECTIVE DATE: 10-31-93
DISTRICT # 1
SGAT Yes No

15-171-20459-0000

FORM MUST BE TYPED
FORM MUST BE SIGNED
ALL BLANKS MUST BE FILLED

State of Kansas
NOTICE OF INTENTION TO DRILL

Must be approved by the K.C.C. (five (5) days prior to commencing well

Expected Spud Date October 15 1993
month day year

Spot NE SW Sec 15 Twp 19 S Rg 33 East West

OPERATOR: License # 5003
Name: McCoy Petroleum Corporation
Address: 110 S. Main, Suite 500
City/State/Zip: Wichita, KS 67202
Contact Person: Robert O'Dell
Phone: (316) 265-9697

1980 feet from South / North line of Section
3300 feet from East / West line of Section
IS SECTION X REGULAR IRREGULAR
(NOTE: Locate well on the Section Plat on Reverse Side)

CONTRACTOR: License # 5658
Name: Sweetman Drilling, Inc

County: Scott
Lease Name: Feiertag "A" Well #: 3-15
Field Name: Hugoton North
Is this a Prorated/Spaced Field? yes X no
Target Formation(s): St. Louis
Nearest lease or unit boundary: 660'
Ground Surface Elevation: 2960 Est. Foot MSL
Water well within one-quarter mile: yes X no
Public water supply well within one mile: yes X no
Depth to bottom of fresh water: 195'
Depth to bottom of useable water: 1250 1400'
Surface Pipe by Alternate: 1 X 2
Length of Surface Pipe Planned to be set: 225'
Length of Conductor pipe required: -0-
Projected Total Depth: 4900'
Formation at Total Depth: Spergen
Water Source for Drilling Operations:
X well farm pond other
OUR Permit #: To be applied for
Will Cores Be Taken? yes X no
If yes, proposed zones:

Well Drilled For: Well Class: Type Equipment:
X Oil Enh Rec Infield X Mud Rotary
Gas Storage X Pool Ext Air Rotary
OUVO Disposal Wildcat Cable
Selsaic: # of Holes Other
Other
If OUVO: old well information as follows:
Operator:
Well Name:
Comp. Date: Old Total Depth

Directional, Deviated or Horizontal wellbore? yes X no
If yes, true vertical depth:
Bottom Hole Location:

AFFIDAVIT

The undersigned hereby affirms that the drilling, completion and eventual plugging of this well will comply with K.S.A. 55-101, et. seq.
It is agreed that the following minimum requirements will be met:

- 1. Notify the appropriate district office prior to spudding of well;
- 2. A copy of the approved notice of intent to drill shall be posted on each drilling rig;
- 3. The minimum amount of surface pipe as specified below shall be set by circulating cement to the top; in all cases surface pipe shall be set through all unconsolidated materials plus a minimum of 20 feet into the underlying formation;
- 4. If the well is dry hole, an agreement between the operator and the district office on plug length and placement is necessary prior to plugging;
- 5. The appropriate district office will be notified before well is either plugged or production casing is cemented in;
- 6. IF AN ALTERNATE II COMPLETION, PRODUCTION PIPE SHALL BE CEMENTED FROM BELOW ANY USABLE WATER TO SURFACE WITHIN 120 DAYS OF SPUD DATE. IN ALL CASES, NOTIFY DISTRICT OFFICE PRIOR TO ANY CEMENTING.

I hereby certify that the statements made herein are true and to the best of my knowledge and belief.
Date: 9-13-93 Signature of Operator or Agent: Robert E. O'Dell Title: Geologist

FOR KCC USE:
API # 15- 171-20459
Conductor pipe required 7100 feet
Minimum surface pipe required 225 feet per Alt. X
Approved by: CB 10-26-93
This authorization expires: 4-26-94
(This authorization void if drilling not started within 6 months of effective date.)
Spud date: Agent:

REMEMBER TO:

- File Drill Pit Application (form CDP-1) with Intent to Drill;
- File Completion Form ACO-1 within 120 days of spud date;
- File acreage attribution plat according to field proration orders;
- Notify appropriate district office 48 hours prior to workover or re-entry;
- Submit plugging report (CP-4) after plugging is completed;
- Obtain written approval before disposing or injecting salt water.

Mail to: Conservation Division, 200 Colorado Derby Building, 202 W. First St., Wichita, Kansas 67202-1286.

RECEIVED
STATE CORPORATION COMMISSION
SEP 15 1993
CONSERVATION DIVISION
Wichita, Kansas

15

IN ALL CASES PLOT THE INTENDED WELL ON THE PLAT BELOW

PLAT OF ACREAGE ATTRIBUTABLE TO A WELL IN A PRORATED OR SPACED FIELD

If the intended well is in a prorated or spaced field, please fully complete this side of the form. If the intended well is in a prorated or spaced field complete the plat below showing that the well will be properly located in relationship to other wells producing from the common source of supply. Please show all the wells within 1 mile of the boundaries of the proposed acreage attribution unit for gas wells and within 1/2 mile of the boundaries of the proposed acreage attribution unit for oil wells.

API NO. 15-
 OPERATOR McCoy Petroleum Corporation
 LEASE Feiertag "A"
 WELL NUMBER 3-15
 FIELD Scott

LOCATION OF WELL: COUNTY Scott
1980 feet from south/north line of section
3300 feet from east/west line of section
 SECTION 15 TWP 19S RC 33W



NUMBER OF ACRES ATTRIBUTABLE TO WELL 40
 QTR/QTR/QTR OF ACREAGE NE SW

IS SECTION X REGULAR or IRREGULAR
 IF SECTION IS IRREGULAR, LOCATE WELL FROM NEAREST CORNER BOUNDARY

Section corner used: NE NW SE SW

PLAT

(Show location of the well and shade attributable acreage for prorated or spaced wells.)
 (Show footage to the nearest lease or unit boundary line.)

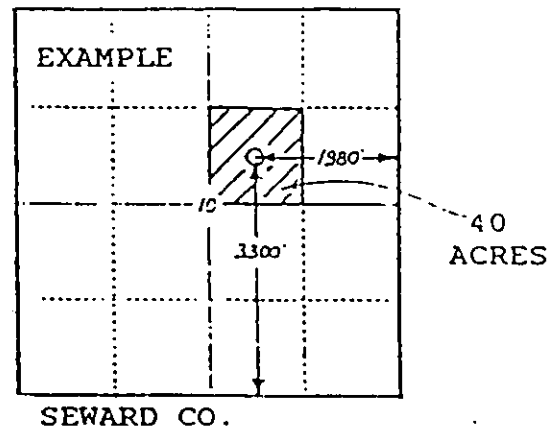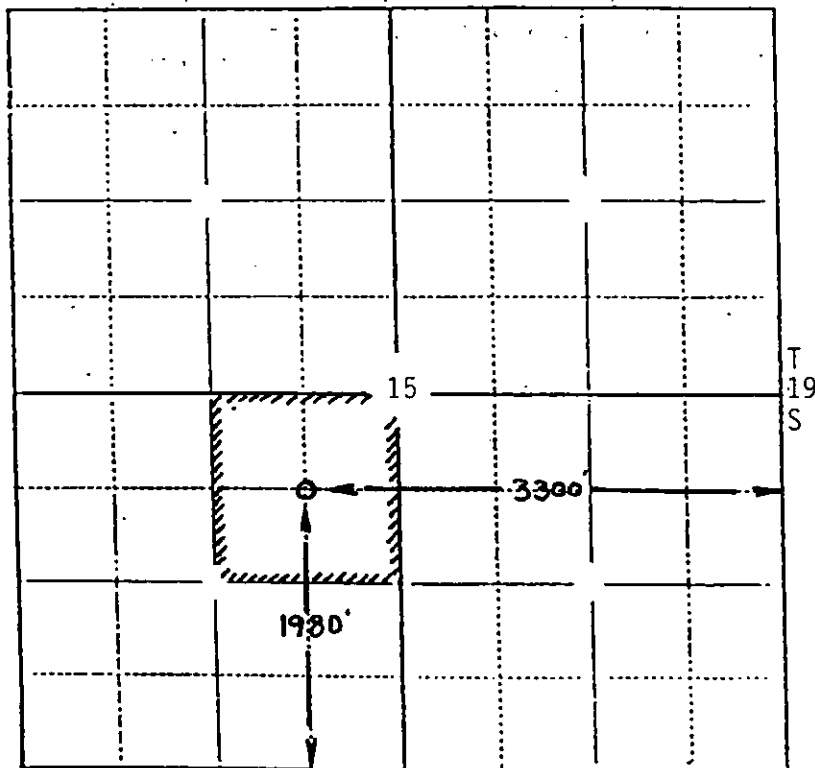

In plotting the proposed location of the well, you must show:

- 1) The manner in which you are using the depicted plat by identifying section lines, i.e. 1 section, 1 section with 8 surrounding sections, 4 sections, etc.;
- 2) the distance of the proposed drilling location from the section's south/north and east/west lines; and
- 3) the distance to the nearest lease or unit boundary line.