


STATE OF KANSAS
STATE CORPORATION COMMISSION

WELL PLUGGING RECORD

Give All Information Completely
Make Required Affidavit
Mail or Deliver Report to
Conservation Division
State Corporation Comm.
245 North Water
Wichita, KS 67202

Greeley County. Sec. 25 Twp. 20 Rge. 41 E/W
Location as "NE/CNW $\frac{1}{4}$ SW $\frac{1}{4}$ " or footage from lines
C-SE-SW
Lease Owner H. & M. Energies Corporation
Lease Name Sleigh Well No. #1
Office Address P.O. Box 1821 Liberal, Kansas 67901
Character of Well (Completed as Oil, Gas or Dry Hole)

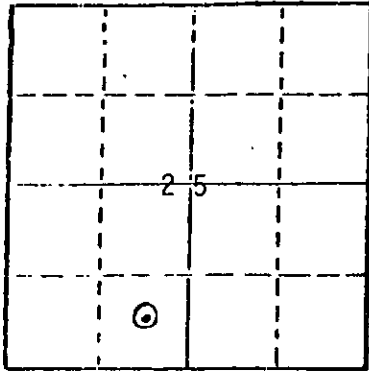

Locate well correctly on above Section Plat

Dry Hole
Date Well completed 7-8-80 1980
Application for plugging filed 7-8- 1980
Application for plugging approved X 1980
Plugging commenced P.M. 7-8-80 1980
Plugging completed 7:00 P.M. 7-8 1980
Reason for abandonment of well or producing formation
Dry Hole

If a producing well is abandoned, date of last production 1980

Was permission obtained from the Conservation Division or its agents before plugging was commenced? Yes

Name of Conservation Agent who supervised plugging of this well
Producing formation None Depth to top Bottom Total Depth of Well 3150
Show depth and thickness of all water, oil and gas formations.

OIL, GAS OR WATER RECORDS

CASING RECORD

FORMATION	CONTENT	FROM	TO	SIZE	PUT IN	PULLED OUT
Surface		0	253	8 5/8	X	Left

Describe in detail the manner in which the well was plugged, indicating where the mud fluid was placed and the method or methods used in introducing it into the hold. If cement or other plugs were used, state the character of same and depth placed, from feet to feet for each plug set.

- Set 70 Sx. Cement @ 900 Ft.
- Spot 20 Sx. Cement @ 240 Ft.
- Spot 10 Sx. Cement 40' to 0
- Cement Rathole

RECEIVED
STATE CORPORATION COMMISSION
JUL 16 1980
CONSERVATION DIVISION
Wichita, Kansas

(If additional description is necessary, use BACK of this sheet)

Name of Plugging Contractor H. & M. Energies - Lakin Drilling Co.

STATE OF KANSAS COUNTY OF SEWARD, ss.
R. L. Higginbottom (employee of owner) or (owner or operator)

of the above-described well, being first duly sworn on oath, says: That I have knowledge of the facts, statements, and matters herein contained and the log of the above-described well as filed and that the same are true and correct. So help me God.

(Signature) R. L. Higginbottom
Box 1821 Liberal, Kansas 67901
(Address)

SUBSCRIBED AND SWORN TO before me this 15th day of July, 1980

A. J. Parnell
Notary Public.

My commission expires

A. J. PARNELL
Seward County, Kansas
My Appt. Exp. 7-7-81

