


15-071-00006-00-00

WELL PLUGGING RECORD

Give All Information Completely
Make Required Affidavit
Mail or Deliver Report to:
Conservation Division
State Corporation Commission
211 No. Broadway
Wichita, Kansas

Greeley County, Sec. 10 Twp. 20S Rge. 41W (E) (W)
Location as "NE/CNW&SW&" or footage from lines SW/4 NE/4
Lease Owner Mack Oil Company
Lease Name Goering Unit Well No. 1
Office Address 812 Union Center
Character of Well (completed as Oil, Gas or Dry Hole) Dry Hole
Date well completed October 10 1961
Application for plugging filed November 13 1961
Application for plugging approved November 13 1961
Plugging commenced December 2 1961
Plugging completed December 3 1961
Reason for abandonment of well or producing formation Dry Hole

NORTH

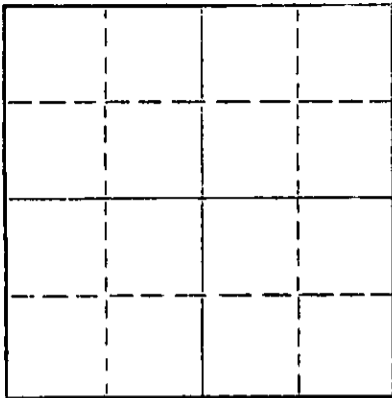

Locate well correctly on above
Section Plat

If a producing well is abandoned, date of last production None 19
Was permission obtained from the Conservation Division or its agents before plugging was commenced? Yes

Name of Conservation Agent who supervised plugging of this well W. I. Lackamp, Jr.
Producing formation None Depth to top Bottom Total Depth of Well 3007 Feet
Show depth and thickness of all water, oil and gas formations.

OIL, GAS OR WATER RECORDS

CASING RECORD

FORMATION	CONTENT	FROM	TO	SIZE	PUT IN	PULLED OUT
Surface Sand & Gravel	Water	0	131	8 5/8	124	None
Permian Sand	Water	0	3003	4 1/2	3306	1765

Describe in detail the manner in which the well was plugged, indicating where the mud fluid was placed and the method or methods used in introducing it into the hole. If cement or other plugs were used, state the character of same and depth placed, from _____ feet to _____ feet for each plug set.

Cast iron bridge at 2795'. Plugged with sand from 2795' to 2760' and with 4 sacks cement on top of sand.
Plugged at 250' with 20 sacks cement.
Plugged at 30' with 10 sacks cement.

12-18-61

(If additional description is necessary, use BACK of this sheet)
Name of Plugging Contractor Mack Oil Company
Address Box 471, Duncan, Oklahoma

STATE OF Kansas, COUNTY OF Sedgwick, ss.
Robert L. Harris (employee of owner) or (owner/operator) of the above-described well, being first duly sworn on oath, says: That I have knowledge of the facts, statements, and matters herein contained and the log of the above-described well as filed and that the same are true and correct. So help me God.

(Signature) Robert L. Harris
812 Union Center, Wichita, Kansas
(Address)

SUBSCRIBED AND SWORN TO before me this 15th day of November, 1961

My commission expires September 8, 1963
Eudora Rae Barasman Notary Public.

NOTARY PUBLIC
 STATE OF OKLAHOMA
 My Commission Expires
 SEPTEMBER 8, 1963

MACK OIL COMPANY
 Duncan, Oklahoma

DRILLERS WELL LOG

Goering #1
 Commenced R.D.: 8-16-61
 Completed R.D.: 8-22-61
 Total Depth: 3010'

C SW NE Sec. 10-20-41W
 Greeley County, Kansas
 Elevation: 3660 K.B.
 Initial Production:
 Contractor: Mack Oil Company

Casing Record: 124' 8 5/8" O. D. Surface Casing
 3306' 4 1/2" O. D. Production Casing

<u>STRATA</u>	<u>DEPTH</u>
Clay	0 - 20
Sand and Shells	20 - 110
Shale	110 - 135
Shale and Shells	135 - 1090
Anhydrite	1090 - 1479
Shale and Shells	1479 - 1772
Anhydrite	1772 - 1790
Shale and Shells	1790 - 2420
Anhydrite	2420 - 2440
Shale and Shells	2440 - 2820
Shale and Sand	2820 - 2935
Lime	2935 - 3010

I hereby certify that the above is a true and correct log of said well as reflected by the daily drilling reports.

MACK OIL COMPANY

By Robert L. Harris

Signed and sworn to in my presence this 13th day of November, 1961, by Robert L. Harris, representative of Mack Oil Company.

Eudora Rae Barackman
 Eudora Rae Barackman
 Notary Public

My commission expires September 8, 1963