


15-071-20129-00-00

STATE OF KANSAS  
STATE CORPORATION COMMISSION

WELL PLUGGING RECORD

Give All Information Completely  
Make Required Affidavit  
Mail or Deliver Report to  
Conservation Division  
State Corporation Comm.  
245 North Water  
Wichita, KS 67202

Greeley County. Sec. 14 Twp. 20 Rge. 42 E/W  
Location as "NE/CNW $\frac{1}{4}$ /SW $\frac{1}{4}$ " or footage from lines C SE NW

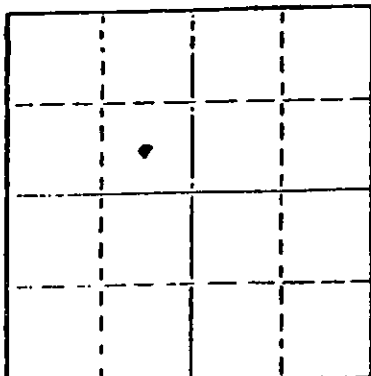

Locate well correctly on above Section Plot

Lease Owner Kirby Exploration  
Lease Name West Well No. 1-14  
Office Address Box 1745, Houston, Texas 77001  
Character of Well (Completed as Oil, Gas or Dry Hole) Gas & Dry

Date Well completed 3-7 1977  
Application for plugging filed 8-7- 1978  
Application for plugging approved 8-8 1978  
Plugging commenced 8-8 1978  
Plugging completed 8-9 1978

Reason for abandonment of well or producing formation None Commercial Value  
If a producing well is abandoned, date of last production 19  
None  
Was permission obtained from the Conservation Division or its agents before plugging was commenced? Yes

Name of Conservation Agent who supervised plugging of this well Mr. Balthazor  
Producing formation Hugoton Depth to top 2831 Bottom 2842 Total Depth of Well 3000'  
Show depth and thickness of all water, oil and gas formations.

OIL, GAS OR WATER RECORDS

CASING RECORD

FORMATION	CONTENT	FROM	TO	SIZE	PUT IN	PULLED OUT
Surface				9 5/8"	555'	0'
Production				5 1/2"	2999'	0'

Describe in detail the manner in which the well was plugged, indicating where the mud fluid was placed and the method or methods used in introducing it into the hold. If cement or other plugs were used, state the character of same and depth placed, from \_\_\_\_\_ feet to \_\_\_\_\_ feet for each plug set.

Pumped 2 sacks hulls & 15 sacks cement to 2750'-Pressured to 750lbs.  
Displaced to 500'  
Pumped 15 sacks cement 500' to 400'  
Displaced to 40'  
Put bridge & 10 sacks cement 40' to 0'.  
Cut 9 5/8" off 42" below ground level.

RECEIVED  
STATE CORPORATION COMMISSION

AUG 15 1978

CONSERVATION DIVISION  
Wichita, Kansas

(If additional description is necessary, use BACK of this sheet)  
Name of Plugging Contractor Midwest Casing Pulling  
Box F, Sublette, Kansas Kans. permit # 766

STATE OF KANSAS COUNTY OF Haskell, ss.  
I Edgar J. Eves (employee of owner) or (owner or operator)  
of the above-described well, being first duly sworn on oath, says: That I have knowledge of the facts, statements, and matters herein contained and the log of the above-described well as filed and that the same are true and correct. So help me God.

(Signature) Edgar J. Eves  
Box F, Sublette, Kansas 67877  
(Address)

SUBSCRIBED AND SWORN TO before me this 10 th day of August, 19 78

Sandra L. Eves  
Notary Public.

My commission expires 12-6-80

