

STATE OF KANSAS
STATE CORPORATION COMMISSION

WELL PLUGGING RECORD

Give All Information Completely
Make Required Affidavit
Mail or Deliver Report to
Conservation Division
State Corporation Comm.
245 North Water
Wichita, KS 67202

Clark County, Sec. 33 Twp. 33 Rge. 23 E/W
Location as "NE/CNW $\frac{1}{4}$ SW $\frac{1}{4}$ " or footage from lines
C-SE-NE-SW

Lease Owner Calvin Exploration Inc.
Lease Name McMillion Well No. 1-33
Office Address 1125 17th St., Suite 2000, Denver, Co. 80202

Character of Well (Completed as Oil, Gas or Dry Hole)
Gas & Oil


Date Well completed 12-12-81 19
Application for plugging filed 12-1-82 19
Application for plugging approved 12-3-82 19
Plugging commenced 1-4-83 19
Plugging completed 1-7-83 19

Reason for abandonment of well or producing formation
Non Commercial Value

If a producing well is abandoned, date of last production
None 19

Was permission obtained from the Conservation Division or
its agents before plugging was commenced? yes

Name of Conservation Agent who supervised plugging of this well Mr. Luthi
Producing formation Swope Depth to top 4930 Bottom 4934 Total Depth of Well 5950'
Show depth and thickness of all water, oil and gas formations.

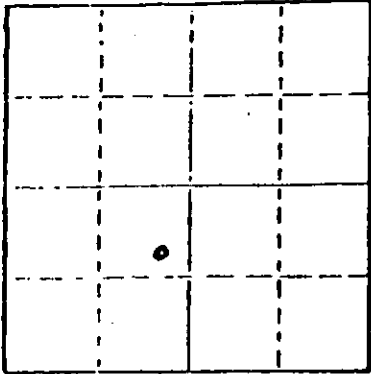

Locate well correctly on above
Section Plat

OIL, GAS OR WATER RECORDS

CASING RECORD

FORMATION	CONTENT	FROM	TO	SIZE	PUT IN	PULLED OUT
Surface				8 5/8"	762	0
Production				4 1/2"	5185	4426"

Describe in detail the manner in which the well was plugged, indicating where the mud fluid
was placed and the method or methods used in introducing it into the hold. If cement or other
plugs were used, state the character of same and depth placed, from _____ feet to
_____ feet for each plug set.

Pumped 2 sks. hulls & 25 sks. cement to 4620' and pressured to 750 lbs.
Layed down 4 1/2" to 1800' and pumped 40 sks. 1800' to 1650'
Layed down 4 1/2" to 820' and pumped 35 sks. 820' to 720'
Layed down rest of 4 1/2"
Put bridge & 10 sks. cement 40' to 0'
Cut off 8 5/8", 3' below ground level

(If additional description is necessary, use BACK of this sheet)

Name of Plugging Contractor Midwest Casing Pulling Service
Lic. # 6497

STATE OF Kansas COUNTY OF Haskell, ss.
I, Edgar J. Eves (employee or owner) or (owner or operator)

of the above-described well, being first duly sworn on oath, says: That I have knowledge of
the facts, statements, and matters herein contained and the log of the above-described well
as filed and that the same are true and correct. So help me God.

(Signature) Edgar J. Eves
Box F, Sublette, Ks. 67877
(Address)

SUBSCRIBED AND SWORN TO before me this 10th day of Jan., 19 83

Sandra L Eves
Notary Public.

My commission expires 12-6-84

RECEIVED
STATE CORPORATION COMMISSION

SDNDRA L. EVES
Haskell County, Ks.
My Appl. Exp. 12-6-84

JAN 18 1983

CONSERVATION DIVISION
Wichita, Kansas