


STATE OF KANSAS  
STATE CORPORATION COMMISSION

Give All Information Completely  
Make Required Affidavit  
Mail or Deliver Report to:  
Conservation Division  
State Corporation Commission  
211 No. Broadway  
Wichita, Kansas

15-071-00023-00-00 Form CP-4  
WELL PLUGGING RECORD

NORTH

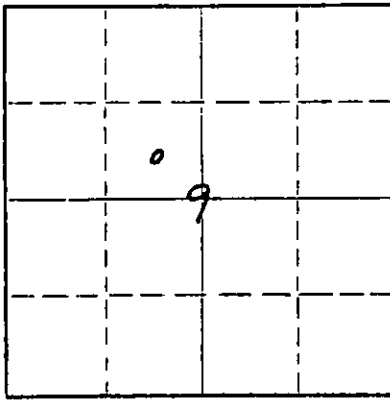

Locate well correctly on above  
Section Plat

Greeley County. Sec. 9 Twp. 20S Rge. 39 XX (W)  
Location as "NE/CNWxSWx" or footage from lines. C/SE/NW  
Lease Owner Hadson Oil & Gas Co.  
Lease Name Miller Well No. 1  
Office Address 316 Oklahoman Bldg., Oklahoma City, Okla.  
Character of Well (completed as Oil, Gas or Dry Hole) Dry Hole  
Date well completed 4/10/63 19\_\_  
Application for plugging filed 9/18/63 19\_\_  
Application for plugging approved Verbal 19\_\_  
Plugging commenced 9/18/63 19\_\_  
Plugging completed 11:00 am 9/20/63 19\_\_  
Reason for abandonment of well or producing formation Not commercial

If a producing well is abandoned, date of last production None 19\_\_  
Was permission obtained from the Conservation Division or its agents before plugging was commenced? Yes w. l.

Name of Conservation Agent who supervised plugging of this well W. L. Nichols  
Producing formation Winfield Depth to top 2804 Bottom 2832 Total Depth of Well 2850 Feet  
Show depth and thickness of all water, oil and gas formations.

OIL, GAS OR WATER RECORDS

CASING RECORD

FORMATION	CONTENT	FROM	TO	SIZE	PUT IN	PULLED OUT
All formations dry				8 5/8	246'	Cemented
See attached Log				4 1/2"	2845'	2300

Describe in detail the manner in which the well was plugged, indicating where the mud fluid was placed and the method or methods used in introducing it into the hole. If cement or other plugs were used, state the character of same and depth placed, from \_\_\_\_\_ feet to \_\_\_\_\_ feet for each plug set.

2840 to 2650 - 20 Sack Cement Plug  
2640 to 300 - Drilling Mud  
300 to 200 - 35 Sacks Cement  
60 to 50 - Rock Bridge  
50 to Surface - 15 Sacks Cement

Cap welded over top of 8 5/8" Casing, 3 feet below ground level. Cellar filled.

RECEIVED  
STATE CORPORATION COMMISSION

SEP 24 1963

CONSERVATION DIVISION  
Wichita, Kansas

(If additional description is necessary, use BACK of this sheet)

Name of Plugging Contractor Sargent's Casing Pulling Service  
Address 121 W. 9th St., Liberal, Kansas

STATE OF \_\_\_\_\_, COUNTY OF \_\_\_\_\_, ss.

\_\_\_\_\_, (employee of owner) or (owner or operator) of the above-described well, being first duly sworn on oath, says: That I have knowledge of the facts, statements, and matters herein contained and the log of the above-described well as filed and that the same are true and correct. So help me God.

(Signature) Donald W. Jackson

(Address)

SUBSCRIBED AND SWORN TO before me this 23rd day of September, 1963

My commission expires February 23, 1967

Notary Public.



INVOICED

DATE 9/24/63

INV. NO. 7991-W

15-071-00023-00-00

LEASE: MILLER #1  
OPERATOR: HANSON OIL & GAS COMPANY  
CONTRACTOR: EARL F. WAKEFIELD  
COMM: 3-25-63 COMP: 3-30-63

LOCATION: SE NW  
SECTION 9-20S-39W  
GREELEY COUNTY, KANSAS  
CASING: 8 5/8" Set at 250'  
4 1/2" Set at 2845'

Surface Soil	25
Sand and Clay	100
Shale	235
Blue Shale	257
Shale	1065
Shale, Shells, Anhydrite	1800
Salt and Shells	2090
Shale and Shells	2225
Red Bed - Shells	2283
Red Bed and Shells	2418
Anhydrite	2436
Shale	2540
Shale and Lime	2727
Lime and Shale	2845
T.D.	2845

STATE OF KANSAS )  
COUNTY OF BRIDGEMAN ) SS

I hereby certify that the above is a true and correct copy of the log on the MILLER #1 well, located SE NW Section 9-20S-39W, Greeley County, Kansas.

EARL F. WAKEFIELD

By Earl F. Wakefield

Subscribed and sworn before me this 8th day of April, 1963.

My commission expires:  
January 25, 1965

Wanda M. Riley  
WANDA M. RILEY NOTARY