

15-071-20034-00-00


STATE OF KANSAS
STATE CORPORATION COMMISSION

WELL PLUGGING RECORD

Give All Information Completely
Make Required Affidavit
Mail or Deliver Report to
Conservation Division
State Corporation Comm.
245 North Water
Wichita, KS 67202

Greeley County. Sec. 8 Twp. 20 Rge. 39 E/W
Location as "NE/CNW 1/4 SW 1/4" or footage from lines
C SW 1/R

Lease Owner Dorchester Exploration Inc.
Lease Name Watson "A" Well No. 1
Office Address 1204 Vaughn Bldg., Midland, Texas
Character of Well (Completed as Oil, Gas or Dry Hole) Gas

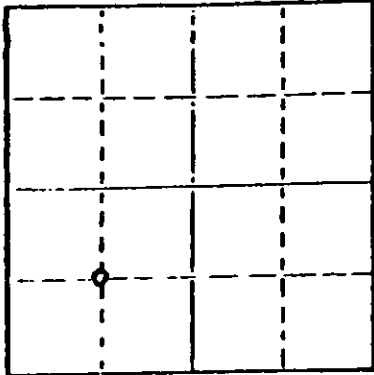

Locate well correctly on above
Section Plot

Date Well completed _____ 19____
Application for plugging filed 7-27-1976 19____
Application for plugging approved 8-3-76 19____
Plugging commenced 7-31-1976 19____
Plugging completed 8-3-1976 19____
Reason for abandonment of well or producing formation
Non Commercial
If a producing well is abandoned, date of last production
Never Produced 19____
Was permission obtained from the Conservation Division or
its agents before plugging was commenced? Yes

Name of Conservation Agent who supervised plugging of this well Mr. Massey
Producing formation Hugoton Depth to top 2830 Bottom 2840 Total Depth of Well 2925'
Show depth and thickness of all water, oil and gas formations.

OIL, GAS OR WATER RECORDS

CASING RECORD

| FORMATION | CONTENT | FROM | TO | SIZE | PUT IN | PULLED OUT |
|-----------|---------|------|-------|--------|--------|------------|
| Surface | | 0' | 283' | 8 5/8" | 283' | 0' |
| Hugoton | | 0' | 2924' | 5 1/2" | 2924' | 1363' |

Describe in detail the manner in which the well was plugged, indicating where the mud fluid was placed and the method or methods used in introducing it into the hold. If cement or other plugs were used, state the character of same and depth placed, from _____ feet to _____ feet for each plug set.

Pumped 2 sacks hulls & 20 sacks cement to 2750'
Mud 2750' to 280'

Pumped 35 sacks cement 280' to 180'
Mud 180' to 45'

Bridge & 10 sackscement 40' to 0'.
Cutoff 8 5/8" 42" below ground level.

RECEIVED
STATE CORPORATION COMMISSION

AUG 26 1976

CONSERVATION DIVISION
Wichita, Kansas

(If additional description is necessary, use BACK of this sheet)

Name of Plugging Contractor Midwest Casing Pulling

STATE OF Kansas COUNTY OF Haskell, ss.
Edgar J. Eves (employee of owner) or (owner or operator) of the above-described

well, being first duly sworn on oath, says: That I have knowledge of the facts, statements, and matters herein contained and the log of the above-described well as filed and that the same are true and correct. So help me God.

(Signature) _____

Box F, Sublette, Kansas 61877
(Address)

Subscribed and sworn to before me this 9 day of Aug 1976

Daniel H. Reinhart
Notary Public.

My commission expires _____



Watson "A" #1

15-071-20034-00-00

STERLING DRILLING COMPANY
P. O. Box 129
Sterling, Kansas 67579

WELL LOC ----- WATSON "A" #1
Located: C SE, Section 8-20S-39W, Greeley County, Kansas

OWNER: Dorchester Exploration, Inc.
ROTARY DRILLING CONTRACTOR: Sterling Drilling Company

COMMENCED: October 30, 1973
COMPLETED: November 3, 1973

TOTAL DEPTH: 2925'

| <u>LOG</u> | <u>CASING RECORD</u> |
|----------------------------|---|
| 0 - 235 Clay and Sand | Ran 6 joints $5\frac{1}{8}$ " new casing, 271.08' set at 282' K.B. with 100 sacks Howco Light and 100 sacks Pozmix "A" with 3% cc. Plug down 4:45 PM, 10-30-73. |
| 235 - 2610 Shale | |
| 2610 - 2925 Lime and Shale | Ran 92 joints 5 1/2" Casing, 2929.5h' cemented at 292h' K.B. with 450 sacks cement. Plug down at 6:00 PM, 11-3-73, by Howco. |

RECEIVED
STATE CORPORATION COMMISSION

AUG 22 1976

CONSERVATION DIVISION
Wichita, Kansas

Original + copies
to M. Blank
11/15/73