

STATE OF KANSAS  
STATE CORPORATION COMMISSION


Give All Information Completely  
Make Required Affidavit  
Mail or Deliver Report to:  
Conservation Division  
State Corporation Commission  
211 No. Broadway  
Wichita, Kansas

15-171-00071-00-00  
WELL PLUGGING RECORD

Scott County, Sec. 1 Twp. 19 Rge. 33W (E) (W)

Location as "NE/CNWxSWx" or footage from lines C SW NW  
Lease Owner E. K. Edmiston and Colorado Interstate Gas Company  
Lease Name Hutchins Well No. -1-  
Office Address 501 First Nat'l Bk. Bldg., Wichita, Kansas  
Character of Well (completed as Oil, Gas or Dry Hole) dry hole  
Date well completed July 25, 1963 19  
Application for plugging filed July 25, 1963 19  
Application for plugging approved July 25, 1963 19  
Plugging commenced July 25, 1963 19  
Plugging completed July 25, 1963 19  
Reason for abandonment of well or producing formation dry hole

NORTH

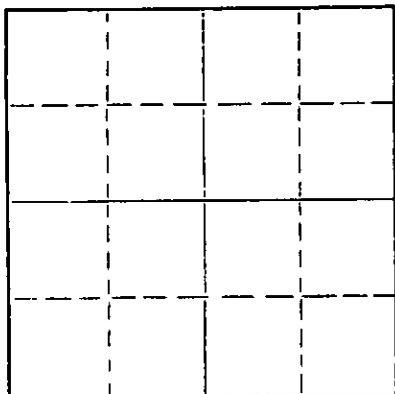

Locate well correctly on above  
Section Plat

If a producing well is abandoned, date of last production - 19  
Was permission obtained from the Conservation Division or its agents before plugging was commenced? yes

Name of Conservation Agent who supervised plugging of this well W. L. Nichols  
Producing formation - Depth to top - Bottom - Total Depth of Well 4920 Feet  
Show depth and thickness of all water, oil and gas formations.

OIL, GAS OR WATER RECORDS

CASING RECORD

FORMATION	CONTENT	FROM	TO	SIZE	PUT IN	PULLED OUT
				8-5/8"	353'	

Describe in detail the manner in which the well was plugged, indicating where the mud fluid was placed and the method or methods used in introducing it into the hole. If cement or other plugs were used, state the character of same and depth placed, from \_\_\_\_\_ feet to \_\_\_\_\_ feet for each plug set.

Set plug at 600 feet with 20 sacks cement  
Second plug at 300 feet with 20 sacks cement  
Third plug at 35 feet with 10 sacks cement

RECEIVED  
STATE CORPORATION COMMISSION

AUG 5 1963

CONSERVATION DIVISION  
Wichita, Kansas

(If additional description is necessary, use BACK of this sheet)

Name of Plugging Contractor E. K. Edmiston Drilling Co., Inc.  
Address 501 First National Bank Building, Wichita, Kansas

STATE OF Kansas, COUNTY OF Sedgwick, ss.  
E. K. Edmiston, operator, of the above-described well, being first duly sworn on oath, says: That I have knowledge of the facts, statements, and matters herein contained and the log of the above-described well as filed and that the same are true and correct. So help me God.  
(Signature) E. K. Edmiston  
(Address)

SUBSCRIBED AND SWORN TO before me this 30th day of July, 1963

A. B. Ergan  
Notary Public.

My commission expires August 25, 1964



15-171-00071-00-00

DRILLER'S LOG

Company: E. K. Edmiston  
 501 First National Bank Building  
 Wichita, Kansas

Rotary Drilling Commenced: July 13, 1963

Rotary Drilling Completed: July 25, 1963

Well Name: Hutchins No. 1  
 C SW NW Sec. 1-19S-33W  
 Scott County, Kansas

Contractor: E. K. Edmiston Drilling Co., Inc.  
 501 First National Bank Building  
 Wichita, Kansas

Casing Record: 8-5/8" at 353' with 250 sacks cement

LOG

Surface	0 - 105
Clay and Sand	215
Clay and Shale	295
Shale	356
Sand and Clay	641
Sand and Shale	1085
Shale and Shells	1685
Shale and Lime	2135
Anhydrite	2630
Shale and Lime	2785
Lime and Shale	2975
Shale and Lime	3230
Lime and Shale	3445
Lime and Chalk	3625
Lime, Chalk and Shale	3880
Lime	4398
Lime and Shale	4530
Lime and Chert	4630
Lime	4694
Shale	4725
Lime	4852
Lime and Shale	4920 RTD

**RECEIVED**  
STATE CORPORATION COMMISSION

AUG 5 1963

CONSERVATION DIVISION  
Wichita, Kansas

The undersigned, E. K. Edmiston, President of E. K. Edmiston Drilling Co., Inc., hereby certifies on behalf of said company that the above log is a true and correct log of the formations encountered in drilling the above well as reflected by the daily drilling reports.

E. K. EDMISTON DRILLING CO., INC.

By *E. K. Edmiston*  
E. K. Edmiston, President

STATE OF KANSAS, COUNTY OF SEDGWICK, SS:

BE IT REMEMBERED that on this 30th day of July, 1963, before me, the undersigned a Notary Public duly commissioned in and for the State and County aforesaid, came E. K. EDMISTON, known to me to be the same person who executed the foregoing instrument as President and on behalf of E. K. Edmiston Drilling Co., Inc., and he duly acknowledged the execution of the same for himself and for said company.

IN WITNESS WHEREOF, I have hereunto set my hand and official seal on the day and year last above written.

*A. B. Bergen*  
A. B. Bergen, Notary Public

My commission expires  
August 25, 1964