

STATE OF KANSAS
STATE CORPORATION COMMISSION

15-171-00023-00-00

Give All Information Completely
Make Required Affidavit
Mail or Deliver Report to:
Conservation Division
State Corporation Commission
212 North Market, Insurance Bldg.
Wichita, Kansas

WELL PLUGGING RECORD

Scott County, Sec. 19 Twp. 17 Rge. 31 (E) W (W)

Location as "NE/CNW/SW" or footage from lines NW NW SW

Lease Owner Bell Oil and Gas Company

Lease Name Brookover Well No. 1

Office Address Box 2007 Tulsa, Oklahoma

Character of Well (completed as Oil, Gas or Dry Hole) Dry Hole

Date well completed May 1 19 61

Application for plugging filed May 1 19 61

Application for plugging approved May 1 19 61


Plugging commenced May 1 19 61

Plugging completed May 1 19 61

Reason for abandonment of well or producing formation no oil and/or gas found in commercial quantities

If a producing well is abandoned, date of last production 19

Was permission obtained from the Conservation Division or its agents before plugging was commenced? yes

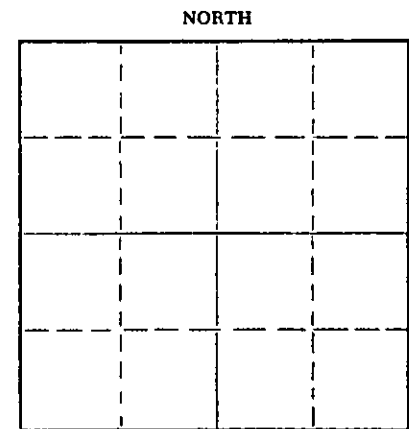

Locate well correctly on above Section Flat

Name of Conservation Agent who supervised plugging of this well Gilbert P. Leiker

Producing formation _____ Depth to top _____ Bottom _____ Total Depth of Well 4705 Feet

Show depth and thickness of all water, oil and gas formations.

OIL, GAS OR WATER RECORDS

CASING RECORD

FORMATION	CONTENT	FROM	TO	SIZE	PUT IN	PULLED OUT
				8-5/8"	at 245'	

Describe in detail the manner in which the well was plugged, indicating where the mud fluid was placed and the method or methods used in introducing it into the hole. If cement or other plugs were used, state the character of same and depth placed, from _____ feet to _____ feet for each plug set.

Filled hole with extra heavy rotary mud from total depth to 480'. Set Plug #1 and 20 sacks cement, Filled hole with extra heavy rotary mud from Plug #1 to 240'. Set Plug #2 at 240' and 20 sacks cement, Filled hole with extra heavy rotary mud from Plug #2 to 40'. Set Plug #3 at 40' and 10 sacks cement.

7

RECEIVED
STATE CORPORATION COMMISSION
MAY 4 1961
CONSERVATION DIVISION
Wichita, Kansas

(If additional description is necessary, use BACK of this sheet)

Name of Plugging Contractor Capitt Drilling, Inc.

Address 814 Union Center, Wichita, Kansas

STATE OF KANSAS, COUNTY OF Sedgwick, ss.

R. R. McNicol (employee of owner) or (owner or operator) of the above-described well, being first duly sworn on oath, says: That I have knowledge of the facts, statements, and matters herein contained and the log of the above-described well as filed and that the same are true and correct. So help me God.

(Signature) R. R. McNicol
814 Union Center, Wichita, Kansas
(Address)

SUBSCRIBED AND SWORN TO before me this 3rd day of May, 19 61

My commission expires Sept. 30, 1963 Darlene May Notary Public.



15-171-00023-00-00

CAPITT DRILLING, INC.
ROTARY DRILLING CONTRACTORS
SUITE 814-16 UNION CENTER
WICHITA 2, KANSAS

May 3, 1961

State Corporation Commission
Conservation Division
500 Insurance Building
Wichita, Kansas

RE: Brookover No. 1
Scott County, Kansas

Gentlemen:

We are enclosing herewith the following instruments
in connection with the drilling and plugging of the
above captioned test:

Surface Casing Affidavit,
Original Rotary Drilling Log,
Original Well Plugging Application,
Original Well Plugging Record,

The above instruments are forwarded for your records.

Very truly yours,

CAPITT DRILLING, INC.

R. R. McNicol

R. R. McNicol

DM/

CC: Bell Oil and Gas Co.
Box 2007
Tulsa, Oklahoma

RECEIVED
STATE CORPORATION COMMISSION

MAY 4 1961

CONSERVATION DIVISION
Wichita, Kansas

15-171-00023-00-00

ROTARY DRILLING LOG

OPERATOR: Bell Oil and Gas Company
No. 1 EDNA BROOKOVER
NW NW SW Section 19-17S-31W,
Scott County, Kansas

CONTRACTOR: Capitt Drilling, Inc.
COMM: 4-16-61
COMP: 5-1-61

Formations:

Remarks: Set 8-5/8" casing at 245'
cemented with 200 sacks
cement.

Surface Soil & Sand	100'
Shale	1615'
Shale & Anhydrite	1854'
Shale	2300'
Lime	2325'
Shale & Lime	2550'
Lime	2885'
Shale & Lime	3030'
Lime	3530'
Lime w/Chalk Streaks	3650'
Lime	3730'
Lime & Chalk	3828'
Lime	4705'
Rotary Total Depth (D&A)	4705'

RECEIVED
STATE CORPORATION COMMISSION
MAY 4 1961
CONSERVATION DIVISION
Wichita, Kansas

We certify the above log is true and correct to the best of our knowledge and belief.

CAPITT DRILLING, INC.

R. R. McNicol

R. R. McNicol

Subscribed and sworn to before me this 3rd day of May, 1961

Darlene May
Darlene May - Notary Public

My Commission Expires:
Sept. 30, 1963