


15-171-20119-00-00

STATE OF KANSAS  
STATE CORPORATION COMMISSION

WELL PLUGGING RECORD

Give All Information Completely  
Make Required Affidavit  
Mail or Deliver Report to  
Conservation Division  
State Corporation Comm.  
245 North Water  
Wichita, KS 67202

Scott County. Sec. 19 Twp. 17S Rge. 31 NE/W  
Location as "NE/CNW SW  $\frac{1}{4}$ " or footage from lines NE SE NE  
Lease Owner Beren Corporation  
Lease Name SEE "A" Well No. 2  
Office Address 970 Fourth Financial Center, Wichita, Ks.  
Character of Well (Completed as Oil, Gas or Dry Hole) Dry Hole  
Date Well completed November 14 1976  
Application for plugging filed (Verbally) November 14 1976  
Application for plugging approved (Verbally) November 14 1976  
Plugging commenced November 14 1976  
Plugging completed November 14 1976  
Reason for abandonment of well or producing formation No commercial quantity of oil or gas encountered  
If a producing well is abandoned, date of last production 19

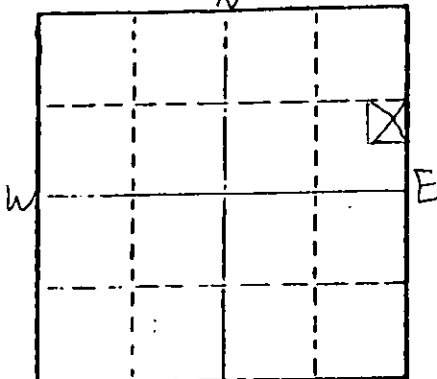

Locate well correctly on above Section Plot

Was permission obtained from the Conservation Division or its agents before plugging was commenced? Yes

Name of Conservation Agent who supervised plugging of this well Gilbert Balthazor  
Producing formation \_\_\_\_\_ Depth to top \_\_\_\_\_ Bottom \_\_\_\_\_ Total Depth of Well \_\_\_\_\_  
Show depth and thickness of all water, oil and gas formations.

OIL, GAS OR WATER RECORDS

CASING RECORD

FORMATION	CONTENT	FROM	TO	SIZE	PUT IN	PULLED OUT

Describe in detail the manner in which the well was plugged, indicating where the mud fluid was placed and the method or methods used in introducing it into the hold. If cement or other plugs were used, state the character of same and depth placed, from \_\_\_\_\_ feet to \_\_\_\_\_ feet for each plug set.

Set 1st plug at 800' with 70 sx.  
Set 2nd plug at 300' with 20 sx.  
Set 3rd plug at 40' with 10 sx. - 50/50 posmix, 6% gel.

Plug was down at 4:15 p.m. 11-14-76.  
State Pluggger - Gilbert Balthazor

(If additional description is necessary, use BACK of this sheet)

Name of Plugging Contractor Abercrombie Drilling, Inc.

STATE OF Kansas COUNTY OF Sedgwick, ss.  
Jack L. Partridge, Asst. Sec.-Treas. (employee of owner) or (owner or operator) of the above-described well, being first duly sworn on oath, says: That I have knowledge of the facts, statements, and matters herein contained and the log of the above-described well as filed and that the same are true and correct. So help me God.

(Signature) Jack L. Partridge  
801 Union Ctr, Wichita, Kansas 67202  
(Address)

SUBSCRIBED AND SWORN TO before me this 19th day of November, 19 76

My commission expires \_\_\_\_\_  
Kathy S. Goertz  
Kathy S. Goertz Notary Public.



CONTRACTOR'S WELL LOG

15-171-20119-00-00

OPERATOR: Beren Corporation  
 CONTRACTOR: Abercrombie Drilling, Inc.  
 WELL NAME: SEE "A" #2  
 LOCATION: NE SE NE, Section 19-17S-31  
 Scott County, Kansas  
 SPUD DATE: November 7, 1976  
 COMPLETION DATE: November 14, 1976

0	50	Sand & Shale
80	250	Sand
250	335	Shale
335	2559	Sand & Shale
2559	2910	Shale & Lime
2910	3474	Lime & Shale
3474	3668	Shale & Lime
3668	3960	Lime & Shale
3960	3968	Shale & Lime
3968	4050	Lime
	4050	Rotary Total Depth

Spud at 2:15 p.m. - 11-07-76. Cut 335' of 12 1/2" hole. Slope 1/2°. Ran 8 jts. of used 8 5/8" 28# surface casing. (Tally 326.22'). Set at 334.22' with 210 sx. 60/40 posmix, 2% gel, 3% Ca.C Cement by Halliburton. Cement dod circulate. Plug was down at 10:00 p.m. 11-07-76.

T.D. 4050'. Set 1st plug at 800' with 70 sx., 2nd plug at 300' with 20 sx., 3rd plug at 40' with 10 sx., 50/50 posmix, 6% gel. Plug was down at 4:15 p.m. 11-14-76. State Plugger Gilbert Balthazor.

SAMPLE TOPS:

Anhydrite 2283'  
 B/Anhydrite 2322'

STATE OF KANSAS )  
 ) SS  
 COUNTY OF SEDGWICK )

Jack L. Partridge, Assistant Secretary-Treasurer of Abercrombie Drilling, Inc., does hereby state that the above and foregoing is a true and correct copy of the log of the SEE "A" #2, NE SE NE, Section 19-17S-31W, Scott County, Kansas.

ABERCROMBIE DRILLING, INC.

BY: Jack L. Partridge

Subscribed and sworn to before me, a Notary Public, in and for the aforesaid county and state as of this 19th day of November, 1976.

Kathy S. Goertz  
 Kathy S. Goertz, Notary Public



COPY