


Give All Information Completely
Make Required Affidavit
Mail or Deliver Report to:
Conservation Division
State Corporation Commission
211 No. Broadway
Wichita, Kansas

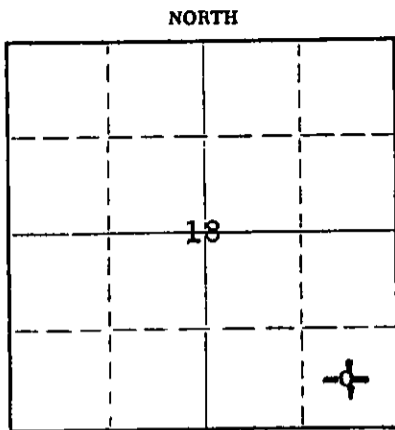

Locate well correctly on above Section Plat

Scott County, Sec. 18 Twp. 17S Rge. 31W (EX (W)
Location as "NE/CNW/SE" or footage from lines C SE SE
Lease Owner D. R. Lauck Oil Company, Inc.
Lease Name Brookover Well No. 2
Office Address 301 S. Broadway, Wichita, Kansas
Character of Well (completed as Oil, Gas or Dry Hole) Dry Hole
Date well completed May 3, 1965
Application for plugging filed May 3, 1965
Application for plugging approved May 3, 1965
Plugging commenced May 3, 1965
Plugging completed May 3, 1965
Reason for abandonment of well or producing formation Dry Hole

If a producing well is abandoned, date of last production 19
Was permission obtained from the Conservation Division or its agents before plugging was commenced? Yes

Name of Conservation Agent who supervised plugging of this well W. L. Nichols
Producing formation _____ Depth to top _____ Bottom _____ Total Depth of Well 4632 Feet
Show depth and thickness of all water, oil and gas formations.

OIL, GAS OR WATER RECORDS

CASING RECORD

FORMATION	CONTENT	FROM	TO	SIZE	PUT IN	PULLED OUT
		0'	283'	8-5/8"	283'	None

Describe in detail the manner in which the well was plugged, indicating where the mud fluid was placed and the method or methods used in introducing it into the hole. If cement or other plugs were used, state the character of same and depth placed, from _____ feet to _____ feet for each plug set.

4632'-600' Mud
600'-596' Plug
596'-546' Cement, 20 sacks
546'-270' Mud
270'-266' Plug
266'-226' Cement, 20 sacks
226'- 40' Mud
40'- 36' Bridge Plug
36'- 6' Cement, 10 sacks (Bottom of Cellar)

STATE CORPORATION COMMISSION
WICHITA, KANSAS

MAY 19 1965

CONSERVATION DIVISION
WICHITA, KANSAS

(If additional description is necessary, use BACK of this sheet)
Name of Plugging Contractor Sun Cementing Co.
Address Great Bend, Kansas

STATE OF KANSAS, COUNTY OF SEDGWICK, ss.
John H. Knightley (employee of owner) or (owner or operator) of the above-described well, being first duly sworn on oath, says: That I have knowledge of the facts, statements, and matters herein contained and the log of the above-described well as filed and that the same are true and correct. (So help me God.)

(Signature) John H. Knightley
301 S. Broadway, Wichita, Kansas
(Address)

SUBSCRIBED AND SWORN TO before me this 17th day of May, 19 65

My commission expires March 12, 1967

Stella J. Lips Notary Public.

D. R. Lauck Oil Company, Inc.

15-171-30005-00-00

Brookover #2

C SE SE Sec. 18-17S-31W
Scott County, Kansas

Commenced: April 21, 1965
Completed: May 3, 1965

Casing Record: 283' 8-5/8" Cemented with 190 sacks Cement,
4 sacks Calcium Chloride.

Elevation: GL 2954; DF 2957; KB 2959.

Drillers Log

Tops

		Sample	Schlumberger
Surface Clay	65	Heebner	3928-969
Sand	215	Toronto	3948-989
Blue Shale	283	Lansing	3968-1009
Shale	1800	B. Kansas City	4359-1400
Shale & Anhydrite	1845	Marmaton Lime	4370-1411
Shale	2130	Cherokee	4542-1583
Shale & Shells	2320	Penn. Sand	4608-1649
Anhydrite	2338	Mississippian	4626-1667
Shale	2400	Total Depth	4632-1673
Shale & Lime	3010		
Shale & Lime Shells	3210	DST #1 (H) 4000-40, open 1 hr. w/strong	
Lime	3225	blow 1 hr. Recovered 2400' water,	
Lime & Shale	3318	50' mud. ISIP 1129#/30 min. FSIP	
Shale & Lime	3388	1121#/30 min. IFP 977#. FFP 1099#.	
Lime & Shale	3495	DST #2 (H) 4055-70, open 1 hr. w/weak	
Shale & Lime, some		blow 30 min. Recovered 10' mud.	
chalky	3660	ISIP 840#/30 min. FSIP 795#/30 min.	
Lime & Shale	3780	IFP 15#. FFP 46#.	
Lime	3875	DST #3 (H) 4215-40, open 1 hr. w/strong	
Shale & Lime	3980	blow 1 hr. Recovered 60' mud,	
Lime	4632 RTD	1520' water. ISIP 1129#/30 min.	
		FSIP 1129#/30 min. IFP 31#. FFP	
		734#.	

D&A

RECEIVED
STATE CORPORATION COMMISSION

MAY 19 1965

CONSERVATION DIVISION
Wichita, Kansas