


Give All Information Completely
Make Required Affidavit
Mail or Deliver Report to:
Conservation Division
State Corporation Commission
211 No. Broadway
Wichita, Kansas

WELL PLUGGING RECORD

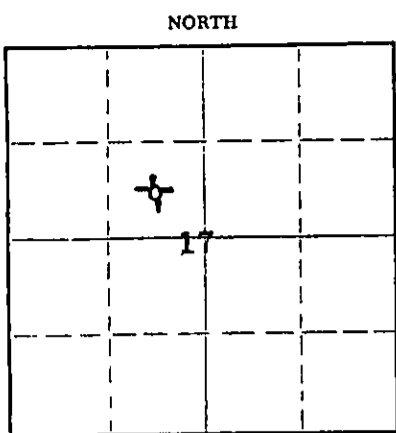

Locate well correctly on above Section Plat

County, Sec. 17 Twp. 17S Rge. 31W (XX) (W)
Location as "NE/CNWxSWx" or footage from lines C SE NW
Lease Owner D. R. Lauck Oil Company, Inc.
Lease Name Rodenberg Well No. 1
Office Address 301 S. Broadway, Wichita, Kansas
Character of Well (completed as Oil, Gas or Dry Hole) Dry Hole
Date well completed December 24, 1964
Application for plugging filed December 24, 1964
Application for plugging approved December 24, 1964
Plugging commenced December 24, 1964
Plugging completed December 24, 1964
Reason for abandonment of well or producing formation Dry Hole

If a producing well is abandoned, date of last production _____ 19____
Was permission obtained from the Conservation Division or its agents before plugging was commenced? Yes

Name of Conservation Agent who supervised plugging of this well Bill Nichols
Producing formation _____ Depth to top _____ Bottom _____ Total Depth of Well 4614 Feet
Show depth and thickness of all water, oil and gas formations.

OIL, GAS OR WATER RECORDS

CASING RECORD

FORMATION	CONTENT	FROM	TO	SIZE	PUT IN	PULLED OUT
		0'	285'	8-5/8"	285'	None

Describe in detail the manner in which the well was plugged, indicating where the mud fluid was placed and the method or methods used in introducing it into the hole. If cement or other plugs were used, state the character of same and depth placed, from _____ feet to _____ feet for each plug set.

4614'-600' Mud
600'-596' Plug
596'-556' Cement, 20 sacks
556'-270' Mud
270'-266' Plug
266'-226' Cement, 20 sacks
226'- 40' Mud
40'- 36' Plug
36'- 6' Cement, 10 sacks (Bottom of Cellar)

FEB 9 1965
02-02-65

(If additional description is necessary, use BACK of this sheet)

Name of Plugging Contractor Globe Cementing Co.
Address Great Bend, Kansas

STATE OF KANSAS, COUNTY OF SEDGWICK, ss.
John H. Knightley (employee of owner) or (~~owner or operator~~) of the above-described well, being first duly sworn on oath, says: That I have knowledge of the facts, statements, and matters herein contained and the log of the above-described well as filed and that the same are true and correct. (So help me God.)

(Signature) John H. Knightley
301 S. Broadway, Wichita, Kansas
(Address)

SUBSCRIBED AND SWORN TO before me this 29th day of December, 1964.

Stella J. Lippa
Notary Public.

My commission expires March 12, 1967

15-171-19008-00-00

9

D. R. Lauck Oil Company, Inc.

Rodenberg #1

C SE NW Sec. 17-17S-31W
Scott County, Kansas

Commenced: December 11, 1964
Completed: December 24, 1964

Casing Record: 285' 8-5/8" Cemented with 175 sacks Cement,
4 sacks Calcium Chloride.

Elevation: 2949 GL; 2952 DF; 2955 KB.

Drillers Log

		Sample	Schlumberger
Surface Clay & Sand Streaks	120		
Sand	175	Heebner 3903-948	3902-947
Blue Shale	285	Toronto 3922-967	3921-966
Shale	1580	Lansing 3941-986	3941-986
Shale & Shells	1790	Base Kansas City 4322-1367	4315-1360
Very Hard Anhydrite, Red Bed & Shale	1817	Marmaton 4327-1372	4322-1367
Red Bed & Shells	2065	Cherokee Shale 4495-1540	4495-1540
Shale, Shells & Red Bed	2295	Sand 4557-1602	4563-1608
Anhydrite	2313	Mississippian 4576-1621	4578-1623
Lime & Shale	2487	Total Depth 4614-1659	4615-1660
Shale & Shells	2990	DST #1 (W) 3970-4005, open 1 hour with strong blow. Recovered 1620' salt water.	
Lime & Shale	3083	ISIP 1133#/30 min.	
Shale & Lime	3150	FSIP 1111#/30 min.	
Lime	3290	IFP 75#	
Lime & Shale	3350	FFP 766#	
Lime	3448	DST #2 (W) 4033-4059, open 1 hour with weak blow thruout. Recovered 210' watery mud.	
Shale & Lime	3615	ISIP 1133#/30 min.	
Lime & Shale	3755	FSIP 1004#/30 min.	
Broken Lime	3870	IFP 21#	
Lime	3940	FFP 97#	
Lime & Shale	4005		
Lime	4614 RTD		

D&A

RECEIVED
STATE COMMISSION COMPTROLLER

FEB 2 1965

CONSERVATION DIVISION
Topeka, Kansas