

15-203-30060-0000

STATE OF KANSAS  
STATE CORPORATION COMMISSION

Form CP-4

Give All Information Completely  
Make Required Affidavit  
Mail or Deliver Report to:  
Conservation Division  
State Corporation Commission  
211 No. Broadway  
Wichita, Kansas

WELL PLUGGING RECORD

Wichita County. Sec. 15 Twp. 20 Rge. 38 (E) (W)

Location as "NE/CNWxSWx" or footage from lines \_\_\_\_\_

Lease Owner Amarillo, Natural Gas Co.

Lease Name Kropp Well No. 1

Office Address 305 Fisk Building Amarillo, Texas

Character of Well (completed as Oil, Gas or Dry Hole) Dry Hole

Date well completed 11-20 19 65

Application for plugging filed 11-20 19 65

Application for plugging approved 11-21 19 65


Plugging commenced 11-21 19 65

Plugging completed 11-21 19 65

Reason for abandonment of well or producing formation \_\_\_\_\_

If a producing well is abandoned, date of last production \_\_\_\_\_ 19 \_\_\_\_\_

Was permission obtained from the Conservation Division or its agents before plugging was commenced? Yes

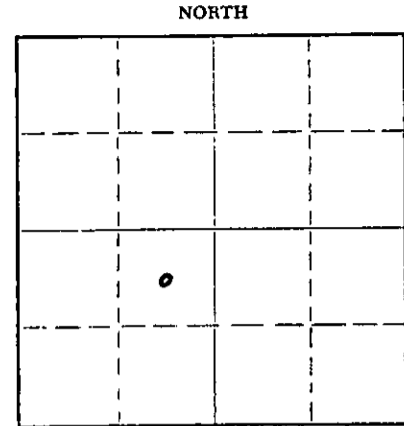

Locate well correctly on above Section Plat

Name of Conservation Agent who supervised plugging of this well Hugh Scott

Producing formation \_\_\_\_\_ Depth to top \_\_\_\_\_ Bottom \_\_\_\_\_ Total Depth of Well 5100 Feet

Show depth and thickness of all water, oil and gas formations.

OIL, GAS OR WATER RECORDS

CASING RECORD

FORMATION	CONTENT	FROM	TO	SIZE	PUT IN	PULLED OUT
Surface		0	459	8 5/8"	459	None

Describe in detail the manner in which the well was plugged, indicating where the mud fluid was placed and the method or methods used in introducing it into the hole. If cement or other plugs were used, state the character of same and depth placed, from \_\_\_\_\_ feet to \_\_\_\_\_ feet for each plug set.

Set Plug @480 to 380'  
Set Plug @40- to 0' By Halliburton

NOV 29 1965

(If additional description is necessary, use BACK of this sheet)  
Name of Plugging Contractor Mahoney Drilling Co. Inc.  
Address Box 1257 Liberal, Kansas 67901

STATE OF Texas COUNTY OF Pottawatomie, ss.  
L. E. Deaffray (employee of owner) or (owner or operator) of the above-described well, being first duly sworn on oath, says: That I have knowledge of the facts, statements, and matters herein contained and the log of the above-described well as filed and that the same are true and correct. So help me God.

(Signature) [Signature]  
305 Fisk Bldg Amarillo, Texas  
(Address)

SUBSCRIBED AND SWORN TO before me this 24 day of November, 1965

My commission expires 6-1-67  
Jeanna Knight Notary Public.

15-203-30060-00-00

KROPP # 1  
Section 15-20S-38W  
Wichita County, Kansas

Set 459' 8-5/8" 400 Sx Cement  
Cement Did Circulate

Set Plug 35 Sx cement 480' to 380'

Set Plug 15 Sx cement 40' to 0'

Sand & Shale	●-454
Red Bed	454-459
Red Bed-Shale	459-1165
Red Bed-Shale-Anhydrite	1165-1478
Sahle-Anhydrite <sup>stks</sup>	1478-2040
Anhydrite-Shale	2040-2740
Lime & Shale	2740-4312
Lime	4312-4957
Lime & Shale	4957-5010
SLime	5010-5100
TD	5100

DEC 12 1965

This is a true and exact copy of the formation taken  
From the Daily Drilling Reports.

*T. W. Mahoney*  
\_\_\_\_\_  
T. W. Mahoney, President

State of Kansas  
County of Seward

Swarn to before me this 23 Day of November, 1965.

*George W. Carnahan, Jr.*  
\_\_\_\_\_  
George W. Carnahan, Jr.  
Notary Public

My Commission Expires January 24, 1968