


WELL PLUGGING RECORD

Give All Information Completely
Make Required Affidavit
Mail or Deliver Report to:
Conservation Division
State Corporation Commission
211 No. Broadway
Wichita, Kansas

WICHITA County. Sec. 21 Twp. 20S Rge. 38 (E) X (W)
Location as "NE/CNWxSWx" or footage from lines C SW/4 OF SE/4
Lease Owner DAVIDOR & DAVIDOR, INC.
Lease Name A. J. RUPP Well No. 1 - 21
Office Address 4515 N. SANTA FE, OKLAHOMA CITY, OKLAHOMA
Character of Well (completed as Oil, Gas or Dry Hole) DRY HOLE
Date well completed JANUARY 13TH 1968
Application for plugging filed JANUARY 14TH 1968
Application for plugging approved JANUARY 14TH 1968
Plugging commenced JANUARY 14TH 1968
Plugging completed JANUARY 14TH 1968
Reason for abandonment of well or producing formation DRY HOLE

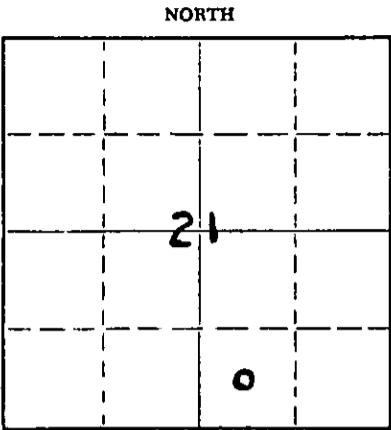

Locate well correctly on above Section Plat

If a producing well is abandoned, date of last production _____ 19____
Was permission obtained from the Conservation Division or its agents before plugging was commenced? YES

Name of Conservation Agent who supervised plugging of this well W. I. NICHOLS, MORLAND, KANSAS
Producing formation _____ Depth to top _____ Bottom _____ Total Depth of Well _____ Feet
Show depth and thickness of all water, oil and gas formations.

OIL, GAS OR WATER RECORDS

CASING RECORD

FORMATION	CONTENT	FROM	TO	SIZE	PUT IN	PULLED OUT
				8-5/8"	330'	NONE

Describe in detail the manner in which the well was plugged, indicating where the mud fluid was placed and the method or methods used in introducing it into the hole. If cement or other plugs were used, state the character of same and depth placed, from _____ feet to _____ feet for each plug set.
HOLE WAS FULL OF MUD. SET 100 SACK CEMENT PLUG FROM 1000' TO 547'. SET 25 SACK CEMENT PLUG FROM 350' TO 250'. SET 10 SACK CEMENT PLUG ON TOP (FROM 35' TO 0').

RECEIVED
STATE CORPORATION COMMISSION
JAN 19 1968
CONSERVATION DIVISION
Wichita, Kansas


(If additional description is necessary, use BACK of this sheet)

Name of Plugging Contractor HALLIBURTON COMPANY AND EARL F. WAKEFIELD
Address HALLIBURTON - LIBERAL, KANSAS EARL F. WAKEFIELD - WICHITA, KANSAS

STATE OF OKLAHOMA, COUNTY OF OKLAHOMA, ss.
HAROLD DAVIDOR (employee of owner) or (owner or operator) of the above-described well, being first duly sworn on oath, says: That I have knowledge of the facts, statements, and matters herein contained and the log of the above-described well as filed and that the same are true and correct. So help me God.

(Signature) Harold Davidor
4515 N. SANTA FE, OKLAHOMA CITY, OKLAHOMA
(Address)

SUBSCRIBED AND SWORN to before me this 18TH day of JANUARY, 1968

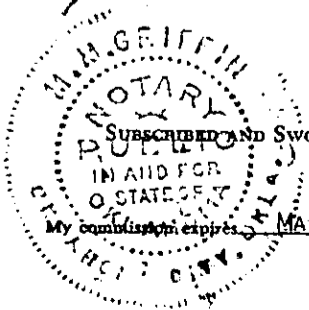

M. M. Griffin
Notary Public.