

STATE OF KANSAS  
STATE CORPORATION COMMISSION

15-171-20160-00-00

WELL PLUGGING RECORD

Give All Information Completely  
Make Required Affidavit  
Mail or Deliver Report to  
Conservation Division  
State Corporation Comm.  
245 North Water  
Wichita, KS 67202

Scott County. Sec. 27 Twp. 17S Rge. 33 E/W  
Location as "NE/CNW $\frac{1}{4}$ SW $\frac{1}{4}$ " or footage from lines  
C SW SE


Lease Owner Kimbark Operating Company  
Lease Name Rudolph Well No. 1  
Office Address 808 Lincoln Tower Bldg., Denver, Colorado  
Character of Well (Completed as Oil, Gas or Dry Hole) 80203  
oil

Date Well completed Sept. 19 1978  
Application for plugging filed Oct. 23 1978  
Application for plugging approved 19  
Plugging commenced Nov. 16 1978  
Plugging completed Dec. 21 1978  
Reason for abandonment of well or producing formation  
depleted

If a producing well is abandoned, date of last production 19

Was permission obtained from the Conservation Division or  
its agents before plugging was commenced? yes

Name of Conservation Agent who supervised plugging of this well Gil Balthazor  
Producing formation \_\_\_\_\_ Depth to top \_\_\_\_\_ Bottom \_\_\_\_\_ Total Depth of Well 4877'  
Show depth and thickness of all water, oil and gas formations.

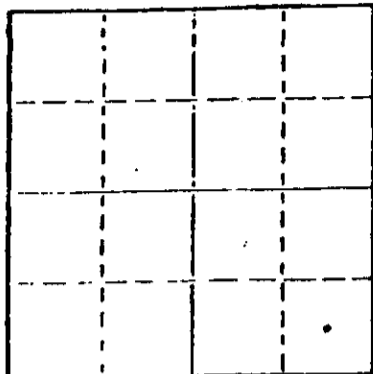

Locate well correctly on above  
Section Plot

OIL, GAS OR WATER RECORDS

CASING RECORD

FORMATION	CONTENT	FROM	TO	SIZE	PUT IN	PULLED OUT
			291'	8 5/8"	291'	none
			4874'	4 1/2"	4874'	2695.50

Describe in detail the manner in which the well was plugged, indicating where the mud fluid  
was placed and the method or methods used in introducing it into the hold. If cement or other  
plugs were used, state the character of same and depth placed, from \_\_\_\_\_ feet to  
\_\_\_\_\_ feet for each plug set.

Sun Oilwell Cementing Inc. plugged bottom pumping in 15 sacks of cement  
pushed with plug.

Sun Cementing Inc. plugged well pumping in 3 sacks of hulls, 10 sacks of  
gel and 130 sacks of cement.

RECEIVED  
STATE CORPORATION COMMISSION

DEC 29 1978

12-29-78


(If additional description is necessary, use BACK of this sheet)  
Name of Plugging Contractor PIPE PULLERS, INC.  
Box 128, Ellinwood, Kansas 67526

CONSERVATION DIVISION  
Wichita, Kansas

STATE OF KANSAS COUNTY OF BARTON, ss.  
Evelyn Roth (employee of owner) or (owner or operator)  
of the above-described well, being first duly sworn on oath, says: That I have knowledge of  
the facts, statements, and matters herein contained and the log of the above-described well  
as filed and that the same are true and correct. So help me God.

(Signature) Evelyn Roth  
Ellinwood, Kansas 67526  
(Address)

SUBSCRIBED AND SWORN TO before me this 28th day of December, 1978

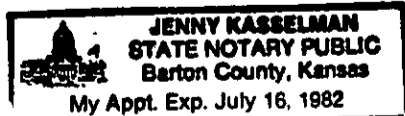

My commission expires

Jenny Kaselman  
Notary Public.

DRILLER'S LOG

15-171-20160-00-00

COMPANY: Kimbark Operating Company

SEC. 27 T. 17S R. 33W

WELL NAME: Rudolph #1

LOC. SW SE

COUNTY: Scott

RIG NO. #1

TOTAL DEPTH 4877'

ELEVATION

COMMENCED: 9-7-78

COMPLETED: 9-19-78

CONTRACTOR: Rains & Williamson Oil Co., Inc.

CASING RECORD:

SURFACE: 8 5/8" @ 291' w/225 sx. common, 3% cc., 2% gel.

PRODUCTION: 4 1/2" @ 4874' w/150 sx. 50/50 poz.

LOG

(Figures Indicate Bottom of Formations)

Shale	579
Shale & Sand	1587
Shale	1893
Shale & Sand	2380
Sand & Shale	2656
Shale	3660
Shale & Lime	3883
Lime	4095
Lime & Shale	4877
<u>ROTARY TOTAL DEPTH</u>	<u>4877</u>

RECEIVED  
 STATE COMMISSIONER OF GEOLOGY  
 OCT 24 1978  
 CONSERVATION DIVISION  
 TOPEKA, KANSAS

STATE OF Kansas )

COUNTY OF Sedgwick )

SS:

I, Wilson Rains, President of Rains & Williamson Oil Co., Inc.

upon oath state that the above and foregoing is a true and correct copy of the log of the

Rudolph #1 well.

*Wilson Rains*

Wilson Rains

Subscribed and sworn to before me this 21 day of September, 1978.

My Appointment Expires:

10-4-79

*Juanita M. Green*

Juanita M. Green

