


STATE OF KANSAS
STATE CORPORATION COMMISSION

15-171-00038-00-00
WELL PLUGGING RECORD

Give All Information Completely
Make Required Affidavit
Mail or Deliver Report to:
Conservation Division
State Corporation Commission
212 North Market, Insurance Bldg.
Wichita, Kansas

Scott _____ County, Sec. 21 Twp. 17S Rge. X(8) 33 (W)
Location as "NE/CNWSWK" or footage from lines. C SE NE
Lease Owner Glenn W. Peel Drilling Co.
Lease Name Herron Well No. 1
Office Address R. R. #3, Box 144B, Wichita 20, Kansas
Character of Well (completed as Oil, Gas or Dry Hole) Dry Hole
Date well completed 11-18 19 60
Application for plugging filed 11-18 19 60
Application for plugging approved 11-18 19 60
Plugging commenced 11-18 19 60
Plugging completed 11-18 19 60
Reason for abandonment of well or producing formation Dry Hole

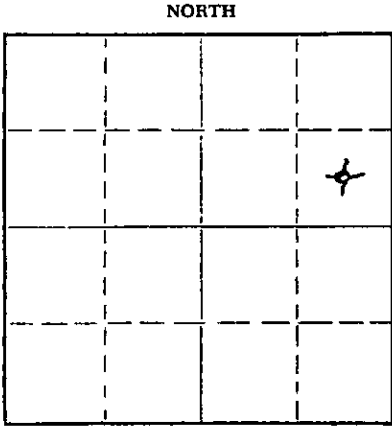

Locate well correctly on above Section Plat

If a producing well is abandoned, date of last production _____ 19____
Was permission obtained from the Conservation Division or its agents before plugging was commenced? Yes

Name of Conservation Agent who supervised plugging of this well Gilbert P. Leiker
Producing formation _____ Depth to top _____ Bottom _____ Total Depth of Well 4770 Feet
Show depth and thickness of all water, oil and gas formations.

OIL, GAS OR WATER RECORDS

CASING RECORD

FORMATION	CONTENT	FROM	TO	SIZE	PUT IN	PULLED OUT
		0	309'	8 5/8"	309	None

Describe in detail the manner in which the well was plugged, indicating where the mud fluid was placed and the method or methods used in introducing it into the hole. If cement or other plugs were used, state the character of same and depth placed, from _____ feet to _____ feet for each plug set.

From 4770' to 501 1/2' - Heavy Rotary Mud
" 501 1/2' to 500' - Wooden Plug
" 500' to 435' - 20 sacks cement.
" 435' to 301 1/2' - Heavy Rotary Mud
" 301 1/2' to 300' - Wooden Plug
" 300' to 238' - 20 sacks cement
" 238' to 41 1/2' - Heavy Rotary Mud
" 41 1/2' to 40' - Wooden Plug
" 40' to 6' - 10 sacks cement
" 6' to surface - Cellar

DEC 5 1960
17-05-60
CONSERVATION DIVISION

(If additional description is necessary, use BACK of this sheet)

Name of Plugging Contractor _____
Address _____

STATE OF KANSAS COUNTY OF SEDGWICK ss.
William Herbert (employee of owner) or (owner) of the above-described well, being first duly sworn on oath, says: That I have knowledge of the facts, statements, and matters herein contained and the log of the above-described well as filed and that the same are true and correct. So help me God.

(Signature) William Herbert
R. R. #3, Box 144B, Wichita 20, Kansas
(Address)

SUBSCRIBED AND SWORN TO before me this 30th day of November, 19 60

Marian M. Herbert
Notary Public.

My commission expires March 4, 1962.

15-171-00038-00-00

DRILLER'S LOG

Company: Glenn W. Peel Drilling Co.

Location: C SW NE
Sec. 21, TWP 17S, Rge 33W

Farm: Herron Well No. 1
Total Depth 4770'

County: Scott,
Kansas

Comm.: 11-1-60 Comp.: 11-18-60
Contractor: Glenn W. Peel Drilling Co.

Elevation:
Production: Dry

Casing: 8 5/8" @ 309' cem.

Figures below indicate bottom of formations

Surface clay	0 -	50'
Sand		90
Shale		675
Shale & shells		1140
Shale		1610
Anhydrite		1645
Shale & shells		2010
Shale w/hard lime streaks		2040
Shale & shells		2175
Shale		2320
Anhydrite		2345
Shale		2415
Shale & shells		2550
Shale w/lime streaks		2705
Lime & shale		3155
Lime		3210
Lime & shale		3275
Lime		3375
Lime & shale		3545
Lime w/shale streaks		3610
Lime		4770
Total Depth		4770

This is to certify that the above information is to the best of my knowledge true and correct.

GLENN W. PEEL DRILLING COMPANY

BY: *Glenn W. Peel*

SUBSCRIBED AND SWORN TO before me this 30th day of November, 1960

My commission expires March 4, 1962.

Marian M. Herbert
Notary Public