

NOTICE OF INTENTION TO DRILL

(see rules on reverse side)

Starting Date October 7 1986
 month day year

API Number 15— 171-20,342-00-00

OPERATOR: License # 5181
 Name SLAWSON, DONALD C.
 Address 200 Douglas Building
 City/State/Zip Wichita, Kansas 67202
 Contact Person Bill Horigan
 Phone (316) 263-3201

..... East
 NW NW SW Sec. 36 Twp. 17 S. Rg. 31... West
 2310' Ft. from South Line of Section
 4950' Ft. from East Line of Section

(Note: Locate well on Section Plat on reverse side)

CONTRACTOR: License # 5657
 Name Slawson Drilling Co.
 City/State Wichita, Kansas

Nearest lease or unit boundary line 330' feet
 County Scott

| | | |
|---|---|--|
| Well Drilled For: | Well Class: | Type Equipment: |
| <input checked="" type="checkbox"/> Oil | <input type="checkbox"/> Infield | <input checked="" type="checkbox"/> Mud Rotary |
| <input type="checkbox"/> SWD | <input checked="" type="checkbox"/> Pool Ext. | <input type="checkbox"/> Air Rotary |
| <input type="checkbox"/> Gas | <input type="checkbox"/> Wildcat | <input type="checkbox"/> Cable |
| <input type="checkbox"/> Inj | | |
| <input type="checkbox"/> OWWO | | |
| <input type="checkbox"/> Expl | | |

Lease Name SCOTT 'E' Well # 1
 Ground surface elevation .. 29.11' GR. (Seis) feet MSL
 Domestic well within 330 feet: yes no
 Municipal well within one mile: yes no

If OWWO: old well info as follows:

Depth to bottom of fresh water 180'
 Depth to bottom of usable water 1450' (550)
 Surface pipe by Alternate: 1 2
 Surface pipe planned to be set 320'
 Conductor pipe required
 Projected Total Depth 4600' feet
 Formation Mississippian

Operator
 Well Name
 Comp Date Old Total Depth

I certify that well will comply with K.S.A. 55-101, et seq., plus eventually plugging hole to KCC specifications.

Date ... 10/6/86 Signature of Operator or Agent

Western Kansas
 District Geologist
 Robert B. Jenkins

For KCC Use:

Conductor Pipe Required 4-6-87 feet; Minimum Surface Pipe Required 225 feet per Alt. 9 (2)
 This Authorization Expires 10-6-86 Approved By


[Handwritten Signature]
 KCC

Must be filed with the K.C.C. five (5) days prior to commencing well
This card void if drilling not started within six (6) months of date received by K.C.C.

Important procedures to follow:

1. Notify District office before setting surface casing.
2. Set surface casing by circulating cement to the top.
3. File completion forms ACO-1 with K.C.C. within 90 days of well completion, following instructions on ACO-1, side 1, and including copies of wireline logs.
4. Notify District office 48 hours prior to old well workover or re-entry.
5. Prior to filing Intent, prepare a proposed plugging plan in case well is D & A, then obtain approval of plan when calling district office prior to setting surface pipe.
6. Submit plugging report (CP-4) to K.C.C. after plugging is completed.
7. Obtain an approved injection docket number before disposing of salt water.
8. Notify K.C.C. within 10 days when injection commences or terminates.

A Regular Section of Land
1 Mile = 5,280 Ft.

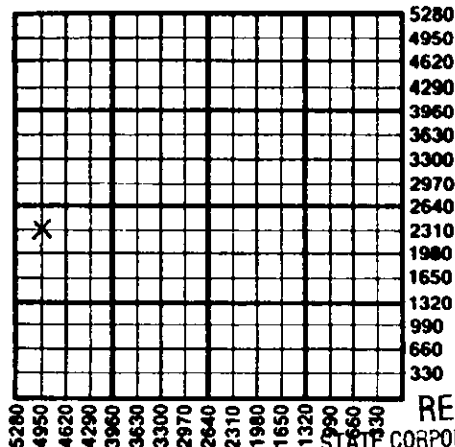

RECEIVED

OCT 6 1986
10-06-86
CONSERVATION DIVISION
Wichita, Kansas

an alternate 2 completion, cement in the production pipe from below any usable water to surface within 120 days of spud date.

State Corporation Commission of Kansas
Conservation Division
200 Colorado Derby Building
Wichita, Kansas 67202
(316) 263-3238