

CARD MUST BE TYPED

State of Kansas

CARD MUST BE SIGNED

NOTICE OF INTENTION TO DRILL

(see rules on reverse side)

Starting Date June 5 1986 month day year 1:46

API Number 15- 171-20,332-00-00

OPERATOR: License # 5181 Name SLAWSON, DONALD C. Address 200 Douglas Building City/State/Zip Wichita, Kansas 67202 Contact Person Bill Horgan Phone (316) 263-3201

SW SW NW Sec 36 Twp 17 S, Rg 31 East West 2970' 4950' Ft. from South Line of Section Ft. from East Line of Section

(Note: Locate well on Section Plat on reverse side)

CONTRACTOR: License # 5657 Name SLAWSON DRILLING CO, City/State Wichita, Kansas

Nearest lease or unit boundary line 330' feet County Scott Lease Name French 'L' Well # 1 Ground surface elevation 2912 GR (Seis) feet MSL

Well Drilled For: Well Class: Type Equipment: X Oil SWD Infield Mud Rotary Gas Inj Pool Ext Air Rotary OWWO Expl Wildcat Cable

Domestic well within 330 feet: yes no Municipal well within one mile: yes no Depth to bottom of fresh water 180' Depth to bottom of usable water 1450' 1550' Surface pipe by Alternate: 1 2 X Surface pipe planned to be set 320' Conductor pipe required Projected Total Depth 4650' feet Foundation Mississippian

If OWWO: old well info as follows:

Operator Well Name Comp Date Old Total Depth

I certify that well will comply with K.S.A. 55-101, et seq., plus eventually plugging hole to KCC specifications. Western Kansas Date 6/4/86 Signature of Operator or Agent Robert B. Jenkins Title District Geologist

For KCC Use:

Conductor Pipe Required feet; Minimum Surface Pipe Required 250 feet per Alt. 90 This Authorization Expires 12-5-86 Approved By 6-5-86


Handwritten signature and initials at bottom right.

Must be filed with the K.C.C. five (5) days prior to commencing well  
This card void if drilling not started within six (6) months of date received by K.C.C.

**Important procedures to follow:**

1. Notify District office before setting surface casing.
2. Set surface casing by circulating cement to the top.
3. File completion forms ACO-1 with K.C.C. within 90 days of well completion, following instructions on ACO-1, side 1, and including copies of wireline logs.
4. Notify District office 48 hours prior to old well workover or re-entry.
5. Prior to filing Intent, prepare a proposed plugging plan in case well is D & A, then obtain approval of plan when calling district office prior to setting surface pipe.
6. Submit plugging report (CP-4) to K.C.C. after plugging is completed.
7. Obtain an approved injection docket number before disposing of salt water.
8. Notify K.C.C. within 10 days when injection commences or terminates.
9. If an alternate 2 completion, cement in the production pipe from now any usable water to surface within 120 days of spud date.

**A Regular Section of Land**  
**1 Mile = 5,280 Ft.**

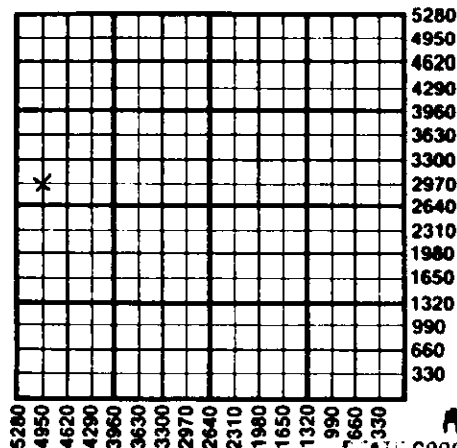

**RECEIVED**

STATE CORPORATION COMMISSION

**JUN 5 - 1980**  
**06-05-80**  
CONSERVATION DIVISION  
Wichita, Kansas

State Corporation Commission of Kansas  
Conservation Division  
200 Colorado Derby Building  
Wichita, Kansas 67202  
(316) 263-3238