

NOTICE OF INTENTION TO DRILL

(see rules on reverse side)

Starting Date ... February 18 1986
month day year 253

OPERATOR: License # 5181
Name SLAWSON, DONALD C.
Address 200 Douglas Building
City/State/Zip Wichita, Kansas 67202
Contact Person Bill Horigan
Phone (316) 263-3201

CONTRACTOR: License # 5657
Name Slawson Drilling Co.
City/State Great Bend, Kansas

Well Drilled For: Well Class: Type Equipment:
X Oil SWD Infield X Mud Rotary
Gas Inj Pool Ext Air Rotary
OWWO Expl X Wildcat Cable

If OWWO: old well info as follows:

Operator
Well Name
Comp Date Old Total Depth

I certify that well will comply with K.S.A. 55-101, et seq., plus eventually plugging hole to KCC specifications.

cementing will be done immediately upon setting production casing.

Date 2/18/86 Signature of Operator or Agent

Robert B. Jenkins

Title District Geologist

For KCC Use:

Conductor Pipe Required 200 feet; Minimum Surface Pipe Required 200 feet per ft.

This Authorization Expires 8-18-86 Approved By 2-18-86

API Number 15- 171-20,325-00-00

NW NW SE Sec 27 Twp 17 S, Rg 31
2310' Ft. from South Line of Section
2260' Ft. from East Line of Section

(Note: Locate well on Section Plat on reverse side)

Nearest lease or unit boundary line 330' feet
County Scott

Lease Name GRUYER 'J' Well # 1

Ground surface elevation 2928. GR. (Seis) feet MSL

Domestic well within 330 feet: yes no

Municipal well within one mile: yes no

Surface pipe by Alternate: 1 2 X

Depth to bottom of fresh water 180'

Depth to bottom of usable water 1450'

Surface pipe planned to be set 320'

Projected Total Depth 4670' feet

Formation Mississippian

Western Kansas

Handwritten signature/initials


Handwritten initials and number 2

Must be filed with the K.C.C. five (5) days prior to commencing well
This card void if drilling not started within six (6) months of date received by K.C.C.

Important procedures to follow:

1. Notify District office before setting surface casing.
2. Set surface casing by circulating cement to the top.
3. File completion forms ACO-1 with K.C.C. within 90 days of well completion, following instructions on ACO-1, side 1, and including copies of wireline logs.
4. Notify District office 48 hours prior to old well workover or re-entry.
5. Prior to filing Intent, prepare a proposed plugging plan in case well is D & A, then obtain approval of plan when calling district office prior to setting surface pipe.
6. Submit plugging report (CP-4) to K.C.C. after plugging is completed.
7. Obtain an approved injection docket number before disposing of salt water.
8. Notify K.C.C. within 10 days when injection commences or terminates.
9. If an alternate 2 completion, cement in the production pipe from below any usable water to surface within 120 days of spud date.

A Regular Section of Land
1 Mile = 5,280 Ft.

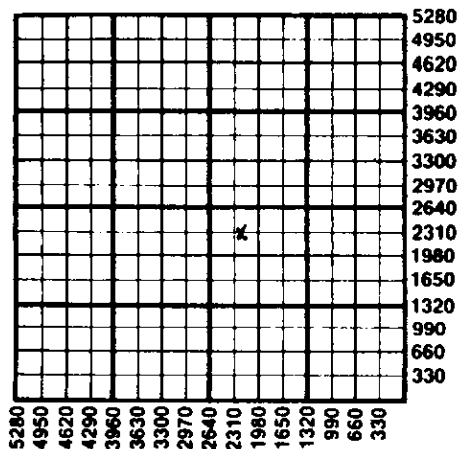

RECEIVED
STATE CORPORATION COMMISSION

FEB 18 1986

CONSERVATION DIVISION
Wichita, Kansas

State Corporation Commission of Kansas
Conservation Division
200 Colorado Derby Building
Wichita, Kansas 67202
(316) 263-3238