


Give All Information Completely  
Make Required Affidavit  
Mail or Deliver Report to:  
Conservation Division  
State Corporation Commission  
211 No. Broadway  
Wichita, Kansas

15-195-00964-0000

WELL PLUGGING RECORD

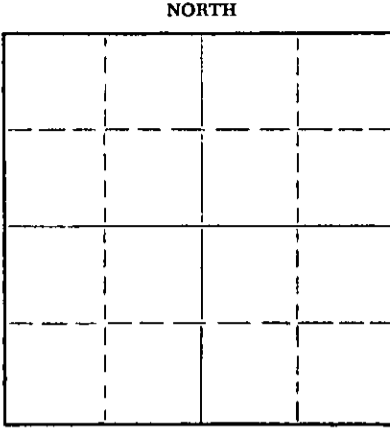

Locate well correctly on above Section Plat

Trego County. Sec. 2 Twp. 11 Rge. 21 (E) 21 (W)  
Location as "NE/CNW/SW" or footage from lines C S 2 NE 4 NE 4  
Lease Owner Herman Geo. Kaiser, Oil Producer  
Lease Name Webb Well No. 2  
Office Address 909 Palace Bldg., Tulsa, Oklahoma  
Character of Well (completed as Oil, Gas or Dry Hole) dry hole  
Date well completed Jan. 12 1957  
Application for plugging filed Jan. 12 1957  
Application for plugging approved Jan. 12 1957  
Plugging commenced Jan. 12 1957  
Plugging completed Jan. 12 1957  
Reason for abandonment of well or producing formation dry

If a producing well is abandoned, date of last production \_\_\_\_\_ 19\_\_\_\_  
Was permission obtained from the Conservation Division or its agents before plugging was commenced? Yes

Name of Conservation Agent who supervised plugging of this well Eldon Petty  
Producing formation \_\_\_\_\_ Depth to top \_\_\_\_\_ Bottom \_\_\_\_\_ Total Depth of Well 3718 Feet  
Show depth and thickness of all water, oil and gas formations.

OIL, GAS OR WATER RECORDS

CASING RECORD

FORMATION	CONTENT	FROM	TO	SIZE	PUT IN	PULLED OUT
				8 5/8	187	None

Describe in detail the manner in which the well was plugged, indicating where the mud fluid was placed and the method or methods used in introducing it into the hole. If cement or other plugs were used, state the character of same and depth placed, from \_\_\_\_\_ feet to \_\_\_\_\_ feet for each plug set.

MUDDIED HOLE TO 180 FEET, SET PLUG AND  
CEMENTED WITH 15 SACKS CEMENT THROUGH  
DRILL PIPE. MUDDIED HOLE TO 40 FT., SET  
PLUG AND CEMENTED WITH 10 SACKS TO  
SURFACE.

(If additional description is necessary, use BACK of this sheet)

Name of Plugging Contractor H-30, INC.  
Address 710 Petroleum Bldg, Wichita, Kansas

STATE OF Kansas, COUNTY OF Sedgwick  
L. C. Sponenberg employee of contractor  
(~~employee of owner~~) of the above-described well, being first duly sworn on oath, says: That I have knowledge of the facts, statements, and matters herein contained and the log of the above-described well as filed and that the same are true and correct. So help me God.

(Signature) L. C. Sponenberg  
(Address) \_\_\_\_\_

SUBSCRIBED AND SWORN TO before me this 21 day of January, 19 57

My commission expires February 13, 1960

Notary Public.

PLUGGING  
SEC 2 T 11 R 21W  
BOOK PAGE 134 LINE 9

1-26-57

KANSAS GEOLOGICAL SOCIETY  
 KANSAS WELL LOG BUREAU - KANSAS WELL SAMPLE BUREAU  
 KANSAS GEOLOGICAL SOCIETY BUILDING  
 508 EAST MURDOCK - WICHITA, KANSAS

15-195-00964-0000

COMPANY Herman Geo. Kaiser & Francis Oil & Gas, Inc.

SEC. 2 T. 11 R. 21W

FARM Webb NO. 2

LOC. C S/2 NE NE

TOTAL DEPTH 3718'

COUNTY Trego


COMM. 1/1/57

COMP. 1/12/57

SHOT OR TREATED

CONTRACTOR H-30, Inc.

ISSUED

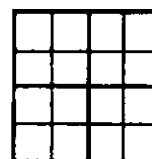

CASING

20	10	
15	8	187'
12	6	
13	5	

ELEVATION 2093

PRODUCTION D & A

FIGURES INDICATE BOTTOM OF FORMATIONS

Top Soil & Clay	30
Clay & Sand Streaks	115
Blue Shale	350
Shale, Clay & Sand Streaks	500
Shale & Iron	1050
Sand	1216
Shale & Shells & Red Bed	1320
Shale & Shells	1528
Anhydrite	1577
Red Bed & Shells	1715
Shale & Shells	2170
Shale & Lime Streaks	2245
Lime & Shale	2381
Lime	2470
Lime & Shale	3398
Lime	3453
Kansas City Lime	3495
Lime	3545
Kansas City Lime	3585
Lime & Shale	3665
Lime & Shale & Chert	3695
Arbuckle	3718

FORMATION TOPS

HEEBNER	3335
TOPEKA	3357
KANSAS CITY	3374
BASE OF KANSAS CITY	3606
CONGLOMERATE	3641
ARBUCKLE	3704

I hereby certify that this is a true and correct log of the above described well as shown by the drilling reports.

H-30, INC.

By *R. P. Spurney*

STATE OF KANSAS )  
 ( SS:  
 COUNTY OF SEDGWICK)

Subscribed and sworn to before me, a notary public, in and for said County and State this 14th day of January, 1957.

PLUGGING  
 SEC 2, T. 11, R. 21W  
 BOOK PAGE 134 LINE 9  
 My commission expires February 13, 1960.

*Rose Turey*  
 Notary Public  
**RECEIVED**  
 STATE CORPORATION COMMISSION

JAN 26 1957

REGISTRATION DIVISION  
 STATE OF KANSAS