

STATE OF KANSAS  
STATE CORPORATION COMMISSION


15101-20395-0000

WELL PLUGGING RECORD

Give All Information Completely  
Make Required Affidavit  
Mail or Deliver Report to  
Conservation Division  
State Corporation Comm.  
245 North Water  
Wichita, KS 67202

Lane \_\_\_\_\_ County. Sec. 1 Twp. 17S Rge. 28W E/W  
Location as "NE/CNW $\frac{1}{2}$ SW $\frac{1}{4}$ " or footage from lines \_\_\_\_\_  
SW SE SW

Lease Owner Abercrombie Drilling, Inc.  
Lease Name BORELL Well No. 1  
Office Address 801 Union Center, Wichita, Kansas 67202  
Character of Well (Completed as Oil, Gas or Dry Hole) \_\_\_\_\_  
Dry Hole

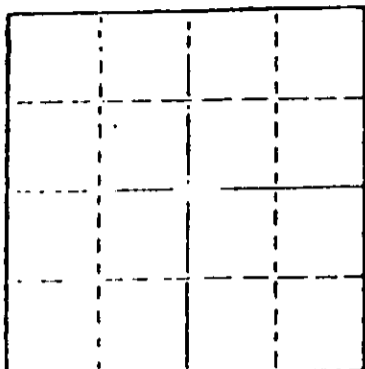

Locate well correctly on above Section Plat

Date Well completed Aug. 27 19 79  
Application for plugging filed (verbally) Aug. 27 19 79  
Application for plugging approved (verbally) Aug. 27 19 79  
Plugging commenced Aug. 27 19 79  
Plugging completed Aug. 27 19 79  
Reason for abandonment of well or producing formation \_\_\_\_\_  
No commercial quantity of oil or gas encountered.  
If a producing well is abandoned, date of last production \_\_\_\_\_  
19 \_\_\_\_\_

Was permission obtained from the Conservation Division or its agents before plugging was commenced? Yes

Name of Conservation Agent who supervised plugging of this well Gilbert Balthazor  
Producing formation \_\_\_\_\_ Depth to top \_\_\_\_\_ Bottom \_\_\_\_\_ Total Depth of Well 4030'  
Show depth and thickness of all water, oil and gas formations.

OIL, GAS OR WATER RECORDS

CASING RECORD

FORMATION	CONTENT	FROM	TO	SIZE	PUT IN	PULLED OUT

Describe in detail the manner in which the well was plugged, indicating where the mud fluid was placed and the method or methods used in introducing it into the hold. If cement or other plugs were used, state the character of same and depth placed, from \_\_\_\_\_ feet to \_\_\_\_\_ feet for each plug set.

T.D. 4030'

Set 1st plug at 850' with 70 sacks

2nd plug at 300' with 20 sacks

3rd plug at 40' with 10 sacks

rathole with 5 sacks.

Cemented with 50/50 posmix, 6% gel.

Job was complete at 8:00 p.m., 8-27-79.

(If additional description is necessary, use BACK of this sheet)

Name of Plugging Contractor Abercrombie Drilling, Inc.

STATE OF Kansas COUNTY OF Sedgwick, ss.  
Jack L. Partridge, Asst. Sec.-Treas. (employee of owner) or (owner or operator)  
of the above-described well, being first duly sworn on oath, says: That I have knowledge of the facts, statements, and matters herein contained and the log of the above-described well as filed and that the same are true and correct. So help me God.

(Signature)

Jack L. Partridge  
801 Union Center, Wichita, Kansas  
(Address)

SUBSCRIBED AND SWORN TO before me this 30th day of August, 19 79



Sherrie L. Brooks  
Sherrie L. Brooks Notary Public.

My commission expires 08-21-82.

RECEIVED  
STATE CORPORATION COMMISSION

SEP - 4 1979  
9-4-79  
CONSERVATION DIVISION  
Wichita, Kansas

**KANSAS DRILLERS LOG**

API No. 15 — 101 — 20,395-0000  
 County Number

Operator  
**Abercrombie Drilling, Inc.**

Address  
**801 Union Center, Wichita, Kansas 67202**

Well No. 1 Lease Name Borell

Footage Location  
330 feet from (N) XX line 1650' feet from (E) XX line

Principal Contractor Abercrombie Drilling Inc. Geologist Vic Reiserer

Spud Date August 22, 1979 Total Depth 4030' P.B.T.D.


Date Completed August 27, 1979 Oil Purchaser

S. 1 T. 17S R. 28W <sup>E</sup>/<sub>W</sub>

Loc. SW SE SW

County Lane

640 Acres  
 N

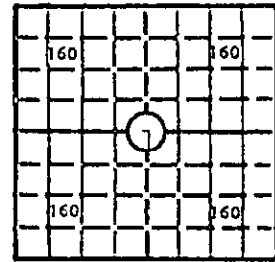

Locate well correctly

Elev.: Gr. 2731'

DF 2734' KB 2736'

**CASING RECORD**

Report of all strings set — surface, intermediate, production, etc.

Purpose of string	Size hole drilled	Size casing set (in O.D.)	Weight lbs/ft.	Setting depth	Type cement	Sacks	Type and percent additives
Surface	12 1/4"	8-5/8"		326'	60/40 posmix	225	3% Ca. Cl. 2% gel.

**LINER RECORD**

**PERFORATION RECORD**

Top, ft.	Bottom, ft.	Sacks cement	Shots per ft.	Size & type	Depth interval

**TUBING RECORD**

Size	Setting depth	Packer set at

**ACID, FRACTURE, SHOT, CEMENT SQUEEZE RECORD**

Amount and kind of material used	Depth interval treated

RECEIVED  
 STATE CORPORATION COMMISSION

SEP - 4 1979

**INITIAL PRODUCTION**

CONSERVATION DIVISION  
 WICHITA, KANSAS

Date of first production \_\_\_\_\_ Producing method (flowing, pumping, gas lift, etc.) \_\_\_\_\_

RATE OF PRODUCTION PER 24 HOURS	Oil	Gas	Water	Gas-oil ratio
	bbls.	MCF	bbls.	CFPB

Disposition of gas (vented, used on lease or sold) \_\_\_\_\_ Producing interval(s) \_\_\_\_\_

INSTRUCTIONS: As provided in KCC Rule 82-2-125, within 90 days after completion of a well, one completed copy of this Drillers Log shall be transmitted to the State Geological Survey of Kansas, 4150 Monroe Street, Wichita, Kansas 67209. Copies of this form are available from the Conservation Division, State Corporation Commission, 3830 So. Meridian (P.O. Box 17027), Wichita, Kansas 66217. Phone AC 316-522-2206. If confidential custody is desired, please note Rule 82-2-125. Drillers Logs will be an open file in the Oil and Gas Division, State Geological Survey of Kansas, Lawrence, Kansas 66044.

Operator **Abercrombie Drilling, Inc.** DESIGNATE TYPE OF COMP.: OIL, GAS, DRY HOLE, SWDW, ETC.: **Dry Hole**

Well No. **1** Lease Name **Borell**

S 1 T 17S R 28W <sup>E</sup><sub>W</sub>


**WELL LOG**

Show all important zones of porosity and contents thereof; cored intervals, and all drill-stem tests, including depth interval tested, cushion used, time tool open, flowing and shut-in pressures, and recoveries.

SHOW GEOLOGICAL MARKERS, LOGS RUN, OR OTHER DESCRIPTIVE INFORMATION.

FORMATION DESCRIPTION, CONTENTS, ETC.	TOP	BOTTOM	NAME	DEPTH
Clay, sand and shale	0	327	<u>SAMPLE TOPS:</u>	
Shale and sand	327	2160		
Anhydrite	2160	2184	Anhydrite	2143' (+ 593)
Lime and shale	2184	2635	B/Anhydrite	2184' (+ 552)
Shale and lime	2635	2832	Heebner	3980' (-1244)
Shale	2832	2946	Toronto	4000' (-1264)
Lime and shale	2946	3457	Lansing	4021' (-1285)
Lime	3457	3698	R.T.D.	4030'
Lime and shale	3698	4030		
Rotary Total Depth		4030		
No drill stem tests were run.				

USE ADDITIONAL SHEETS, IF NECESSARY, TO COMPLETE WELL RECORD.

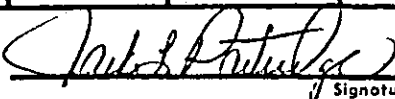Date Received	 Signature <u>Jack L. Partridge, Asst. Secretary-Treas.</u> Title <u>August 30, 1979</u> Date
---------------	--