

2<sup>ND</sup> CORRECTED  
1-31-2012

\* Corrected \*  
\* \* Corrected \* \*

CORRECTED

For KCC Use: 813-2011  
Effective Date: 3  
District #: 3  
SGA?  Yes  No

KANSAS CORPORATION COMMISSION  
OIL & GAS CONSERVATION DIVISION

Form C-1  
March 2010  
Form must be Typed  
Form must be Signed  
All blanks must be Filled

NOTICE OF INTENT TO DRILL

Must be approved by KCC five (5) days prior to commencing well  
Form KSONA-1, Certification of Compliance with the Kansas Surface Owner Notification Act, MUST be submitted with this form.

Expected Spud Date: August 17, 2011  
month day year

Spot Description: \* SW NW NE NW \* NW-NW-NE NW

OPERATOR: License# 34592  
Name: Kansas Resource Exploration & Development, LLC  
Address 1: 9393 W. 116th St., Suite 500

NE NE SE NW Sec. 14 Twp. 14 S. R. 22  E  W  
feet from  N /  S Line of Section  
feet from  E /  W Line of Section

Address 2: \_\_\_\_\_  
City: Overland Park State: KS Zip: 66210

Is SECTION:  Regular  Irregular?  
(Note: Locate well on the Section Plat on reverse side)

Contact Person: Brad Kramer  
Phone: (913) 689-2253

County: Johnson  
Lease Name: Knabe D Well #: KR-3  
Field Name: Gardner

CONTRACTOR: License# 8509  
Name: Evans Energy Development, Inc.

Is this a Prorated / Spaced Field?  Yes  No  
Target Formation(s): Cherokee Group

Well Drilled For:  Oil  Gas  
Well Class:  Infield  Pool Ext.  Wildcat  
Type Equipment:  Air Rotary  Cable  
# of Holes: \_\_\_\_\_  
Other: \_\_\_\_\_  
 If OWWO: old well information as follows:

Nearest Lease or unit boundary line (in footage): 10' - \* 307 \* 284  
Ground Surface Elevation: 1023 Estimated 1041 feet MSL  
Water well within one-quarter mile:  Yes  No  
Public water supply well within one mile:  Yes  No  
Depth to bottom of fresh water: 200  
Depth to bottom of usable water: 300  
Surface Pipe by Alternate:  I  II  
Length of Surface Pipe Planned to be set: 20'  
Length of Conductor Pipe (if any): \_\_\_\_\_  
Projected Total Depth: 800'  
Formation at Total Depth: Barbesville

Operator: \_\_\_\_\_  
Well Name: \_\_\_\_\_  
Original Completion Date: \_\_\_\_\_ Original Total Depth: \_\_\_\_\_

Water Source for Drilling Operations:  Well  Farm Pond  Other: \_\_\_\_\_  
DWR Permit #: \_\_\_\_\_  
(Note: Apply for Permit with DWR )

Directional, Deviated or Horizontal wellbore?  Yes  No  
If Yes, true vertical depth: \_\_\_\_\_  
Bottom Hole Location: \_\_\_\_\_

Will Cores be taken?  Yes  No  
If Yes, proposed zone: \_\_\_\_\_

\* WAS: NE-NE-SE-NW 3922 FSL; 2310 FEL; NLUB 170 Elev. 1027  
IS: SW-NW-NE-NW 4913 FSL; 3744 FEL; NLUB 367 Elev. 1041

The undersigned hereby affirms that the drilling, completion and eventual plugging of this well will comply with K.S.A. 55 et. seq.  
It is agreed that the following minimum requirements will be met: \* WAS: SW-NW-NE-NW 4913 FSL 3744 FEL NLUB 367

1. Notify the appropriate district office prior to spudding of well. 1-31-12 IS: NWNW-NE-NW 4973 FSL 3757 FEL NLUB 284
2. A copy of the approved notice of intent to drill shall be posted on each drilling rig;
3. The minimum amount of surface pipe as specified below shall be set by circulating cement to the top; in all cases surface pipe shall be set through all unconsolidated materials plus a minimum of 20 feet into the underlying formation.
4. If the well is dry hole, an agreement between the operator and the district office on plug length and placement is necessary prior to plugging;
5. The appropriate district office will be notified before well is either plugged or production casing is cemented in;
6. If an ALTERNATE II COMPLETION, production pipe shall be cemented from below any usable water to surface within 120 DAYS of spud date. Or pursuant to Appendix "B" - Eastern Kansas surface casing order #133,891-C, which applies to the KCC District 3 area, alternate II cementing must be completed within 30 days of the spud date or the well shall be plugged. In all cases, NOTIFY district office prior to any cementing.

RECEIVED  
AUG 13 2011

I hereby certify that the statements made herein are true and to the best of my knowledge and belief.  
Date: 7-25-11 Signature of Operator or Agent: [Signature] Title: Agent KCC WICHITA

For KCC Use ONLY  
API # 15 - 091-23538-00-00  
Conductor pipe required: None feet  
Minimum surface pipe required: 20 feet per ALT.  I  II  
Approved by: [Signature] 8-8-2011 / [Signature] 9-9-2011 / [Signature] 1-31-12  
This authorization expires: 8-8-2012  
(This authorization void if drilling not started within 12 months of approval date)  
Spud date: \_\_\_\_\_ Agent: \_\_\_\_\_

- Remember to:
- File Certification of Compliance with the Kansas Surface Owner Notification Act (KSONA-1) with Intent to Drill;
  - File Drill Pit Application (form GDP-1) with Intent to Drill;
  - File Completion Form ACO-1 within 120 days of spud date;
  - File acreage attribution plat according to field prorations orders;
  - Notify appropriate district office 48 hours prior to workover or re-entry;
  - Submit plugging report (CP-4) after plugging is completed (within 60 days);
  - Obtain written approval before disposing or injecting salt water.
  - If well will not be drilled or permit has expired (See authorized expiration date) please check the box below and return to the address below.
- Well will not be drilled or Permit Expired Date: \_\_\_\_\_  
Signature of Operator or Agent: \_\_\_\_\_

14  
14  
22  
 E  
 W

Mail to: KCC - Conservation Division,  
130 S. Market - Room 2078, Wichita, Kansas 67202

RECEIVED

SEP 09 2011 RECEIVED  
KCC WICHITA JAN 30 2012

KCC WICHITA

~~\* corrected \*~~  
~~\* corrected \*~~

2<sup>nd</sup> CORRECTED

Side Two

CORRECTED

For KCC Use ONLY  
 API # 15 - \_\_\_\_\_

**IN ALL CASES PLOT THE INTENDED WELL ON THE PLAT BELOW**

In all cases, please fully complete this side of the form. Include items 1 through 5 at the bottom of this page.

Operator: Kansas Resource Exploration & Development, LLC  
 Lease: Knabe D  
 Well Number: KR-3  
 Field: Gardner

Location of Well: County: Johnson  
 feet from  N /  S Line of Section  
 feet from  E /  W Line of Section  
 Sec. 14 Twp. 14 S. R. 22  E  W

Number of Acres attributable to well: \_\_\_\_\_  
 QTR/QTR/QTR/QTR of acreage: NE - NE - SE - NW

Is Section:  Regular or  Irregular


\* SW NW NE NW  
 \* NW NW NE NW

If Section is Irregular, locate well from nearest corner boundary.  
 Section corner used:  NE  NW  SE  SW

**PLAT**


Show location of the well. Show footage to the nearest lease or unit boundary line. Show the predicted locations of lease roads, tank batteries, pipelines and electrical lines, as required by the Kansas Surface Owner Notice Act (House Bill 2032).  
 You may attach a separate plat if desired.

Sec 14

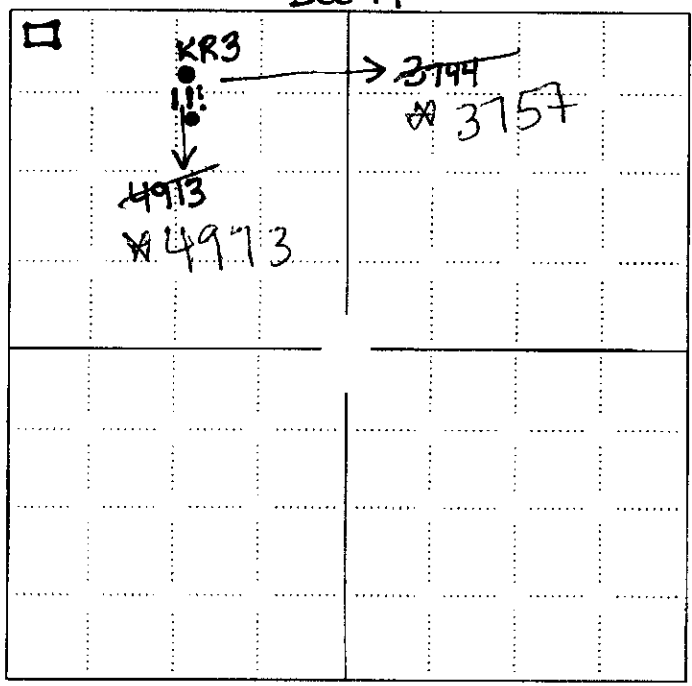

**LEGEND**

- Well Location
- Tank Battery Location
- Pipeline Location
- Electric Line Location
- Lease Road Location

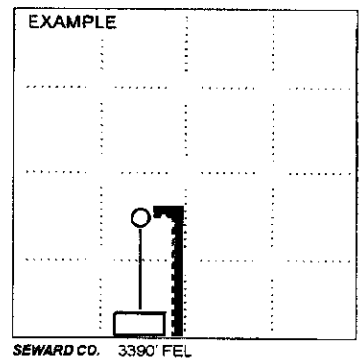

NOTE: In all cases locate the spot of the proposed drilling location.

**In plotting the proposed location of the well, you must show:**

1. The manner in which you are using the depicted plat by identifying section lines, i.e. 1 section, 1 section with 8 surrounding sections, 4 sections, etc.
2. The distance of the proposed drilling location from the south / north and east / west outside section lines.
3. The distance to the nearest lease or unit boundary line (in footage).
4. If proposed location is located within a prorated or spaced field a certificate of acreage attribution plat must be attached: (CO-7 for oil wells, CG-8 for gas wells).
5. The predicted locations of lease roads, tank batteries, pipelines, and electrical lines.

RECEIVED  
 2011 09 20  
 KCC WICHITA

RECEIVED  
 JAN 30 2012  
 KCC WICHITA

RECEIVED  
SEP 09 2011  
KCC WICHITA

\* Corrected \*  
\* Corrected \*

2nd  
CORRECTED

15-09123538-0000  
KANSAS CORPORATION COMMISSION  
OIL & GAS CONSERVATION DIVISION

CORRECTED

Form KSONA-1  
July 2010  
Form Must Be Typed  
All blanks must be Filled

**CERTIFICATION OF COMPLIANCE WITH THE  
KANSAS SURFACE OWNER NOTIFICATION ACT**

*This form must be submitted with all Forms C-1 (Notice of Intent to Drill); CB-1 (Cathodic Protection Borehole Intent);  
T-1 (Request for Change of Operator Transfer of Injection or Surface Pit Permit); and CP-1 (Well Plugging Application).  
Any such form submitted without an accompanying Form KSONA-1 will be returned.*

Select the corresponding form being filed:  C-1 (Intent)  CB-1 (Cathodic Protection Borehole Intent)  T-1 (Transfer)  CP-1 (Plugging Application)

OPERATOR: License # 34592  
Name: Kansas Resource Exploration & Development, LLC  
Address 1: 9393 W. 110th St., Suite 500  
Address 2: \_\_\_\_\_  
City: Overland Park State: KS Zip: 66210  
Contact Person: Brad Kramer  
Phone: ( 913 ) 669-2253 Fax: ( 913 ) 451-6750  
Email Address: kramerbradley@yahoo.com

\* SW NW NE NW \*  
Well Location: NE NE SE NW Sec. 14 Twp. 14 S R. 22  East  West  
County: Johnson  
Lease Name: Knabe D Well #: KR-3

*If filing a Form T-1 for multiple wells on a lease, enter the legal description of the lease below:*

Surface Owner Information:  
Name: Ronald & Susan Rushing  
Address 1: 661 N Pine Cir.  
Address 2: \_\_\_\_\_  
City: Gardner State: KS Zip: 66030

*When filing a Form T-1 involving multiple surface owners, attach an additional sheet listing all of the information to the left for each surface owner. Surface owner information can be found in the records of the register of deeds for the county, and in the real estate property tax records of the county treasurer.*

*If this form is being submitted with a Form C-1 (Intent) or CB-1 (Cathodic Protection Borehole Intent), you must supply the surface owners and the KCC with a plat showing the predicted locations of lease roads, tank batteries, pipelines, and electrical lines. The locations shown on the plat are preliminary non-binding estimates. The locations may be entered on the Form C-1 plat, Form CB-1 plat, or a separate plat may be submitted.*

Select one of the following:

- I certify that, pursuant to the Kansas Surface Owner Notice Act (House Bill 2032), I have provided the following to the surface owner(s) of the land upon which the subject well is or will be located: 1) a copy of the Form C-1, Form CB-1, Form T-1, or Form CP-1 that I am filing in connection with this form; 2) if the form being filed is a Form C-1 or Form CB-1, the plat(s) required by this form; and 3) my operator name, address, phone number, fax, and email address.
- I have not provided this information to the surface owner(s). I acknowledge that, because I have not provided this information, the KCC will be required to send this information to the surface owner(s). To mitigate the additional cost of the KCC performing this task, I acknowledge that I am being charged a \$30.00 handling fee, payable to the KCC, which is enclosed with this form.

*If choosing the second option, submit payment of the \$30.00 handling fee with this form. If the fee is not received with this form, the KSONA-1 form and the associated Form C-1, Form CB-1, Form T-1, or Form CP-1 will be returned.*

I hereby certify that the statements made herein are true and correct to the best of my knowledge and belief.  
Date: 7-25-11 Signature of Operator or Agent: BK Title: Agent

RECEIVED  
AUG 03 2011  
KCC WICHITA

Mail to: KCC - Conservation Division, 130 S. Market - Room 2078, Wichita, Kansas 67202

RECEIVED  
JAN 30 2012  
KCC WICHITA

RECEIVED  
 SEP 09 2011  
 KCC WICHITA

*\* Corrected \**  
 \* CORRECTED \*

2<sup>ND</sup>  
 CORRECTED  
 CORRECTED

KANSAS CORPORATION COMMISSION  
 OIL & GAS CONSERVATION DIVISION  
 APPLICATION FOR SURFACE PIT

Form CDP-1  
 May 2010  
 Typed

Submit in Duplicate

Operator Name: Kansas Resource Exploration & Development, LLC		License Number: 34592	
Operator Address: 9393 W. 110th St., Suite 500		Overland Park KS 66210	
Contact Person: Brad Kramer		Phone Number: (913) 669-2253	
Lease Name & Well No.: Knabe D KR-3		Pit Location (QQQQ): * SW NE NW NE NE SE NW NW NE-NW	
Type of Pit: <input type="checkbox"/> Emergency Pit <input type="checkbox"/> Burn Pit <input type="checkbox"/> Settling Pit <input checked="" type="checkbox"/> Drilling Pit <input type="checkbox"/> Workover Pit <input type="checkbox"/> Haul-Off Pit <small>(If WP Supply API No or Year Drilled)</small>		Pit is: <input checked="" type="checkbox"/> Proposed <input type="checkbox"/> Existing If Existing, date constructed: 4-9-13 Pit capacity: 120 (bbls)	
Is the pit located in a Sensitive Ground Water Area? <input type="checkbox"/> Yes <input checked="" type="checkbox"/> No		Sec. 14 Twp. 14 R. 22 <input checked="" type="checkbox"/> East <input type="checkbox"/> West 3,822 Feet from <input type="checkbox"/> North / <input checked="" type="checkbox"/> South Line of Section 2,810 Feet from <input checked="" type="checkbox"/> East / <input type="checkbox"/> West Line of Section Johnson County	
Is the bottom below ground level? <input checked="" type="checkbox"/> Yes <input type="checkbox"/> No		Chloride concentration: _____ mg/l <small>(For Emergency Pits and Settling Pits only)</small>	
Artificial Liner? <input type="checkbox"/> Yes <input checked="" type="checkbox"/> No		How is the pit lined if a plastic liner is not used? Native Clay	
Pit dimensions (all but working pits):    15 Length (feet)    10 Width (feet)		<input type="checkbox"/> N/A: Steel Pits <input type="checkbox"/> No Pit	
Depth from ground level to deepest point: 5 (feet)			
If the pit is lined give a brief description of the liner material, thickness and installation procedure.		Describe procedures for periodic maintenance and determining liner integrity, including any special monitoring.	
Distance to nearest water well within one-mile of pit: N/A feet    Depth of water well _____ feet		Depth to shallowest fresh water _____ feet Source of information: <input type="checkbox"/> measured <input type="checkbox"/> well owner <input type="checkbox"/> electric log <input checked="" type="checkbox"/> KDWR	
<b>Emergency, Settling and Burn Pits ONLY:</b> Producing Formation: _____ Number of producing wells on lease: _____ Barrels of fluid produced daily: _____ Does the slope from the tank battery allow all spilled fluids to flow into the pit? <input type="checkbox"/> Yes <input type="checkbox"/> No		<b>Drilling, Workover and Haul-Off Pits ONLY:</b> Type of material utilized in drilling/workover: Drilling Mud Number of working pits to be utilized: 2 Abandonment procedure: Air dry and backfill Drill pits must be closed within 365 days of spud date.	
I hereby certify that the above statements are true and correct to the best of my knowledge and belief.			
Date: 7-25-11		Signature of Applicant or Agent: <i>BK</i>	

15-091-235380000

RECEIVED  
 AUG 03 2011

KCC WICHITA

KCC OFFICE USE ONLY			
Date Received: 8-3-11	Permit Number: _____	Permit Date: 8-3-11	Lease Inspection: <input type="checkbox"/> Yes <input checked="" type="checkbox"/> No
<input type="checkbox"/> Liner <input type="checkbox"/> Steel Pit <input type="checkbox"/> RFAC <input type="checkbox"/> RFAS			

Mail to: KCC - Conservation Division, 130 S. Market - Room 207B, Wichita, Kansas 67202

RECEIVED

JAN 30 2012

KCC WICHITA