

For KCC Use: 4-13-01
Effective Date: 4-13-01
District # 1
SGA? Yes No

KANSAS CORPORATION COMMISSION
OIL & GAS CONSERVATION DIVISION

Form C-1
September 1999
Form must be Typed
Form must be Signed
All blanks must be Filled
15-171-20561-000

NOTICE OF INTENT TO DRILL

Must be approved by KCC five (5) days prior to commencing well

Expected Spud Date April 26 2001
month day year

OPERATOR: License# 31251
Name: WABASH ENERGY CORPORATION
Address: P.O. Box 595
City/State/Zip: Lawrenceville, IL 62439
Contact Person: E.L. Whitmer, Jr.
Phone: (618) 943-3365

CONTRACTOR: License# 31548
Name: Discovery Drilling Co., Inc.

Spot 49'N of East
C - E/2 - SW Sec. 31 Twp. 17S S. R. 31W West
1369 feet from (S) / N (circle one) Line of Section
1980 feet from E / (W) (circle one) Line of Section
Is SECTION Regular Irregular?

(Note: Locate well on the Section Plat on reverse side)

County: Scott
Lease Name: Strickert Well #: 11
Field Name: Beckley North Ext.

Is this a Prorated / Spaced Field? Yes No

Target Information(s): LKC & Cherokee
Nearest Lease or unit boundary: 660' ✓
Ground Surface Elevation: 2964 feet MSL

Water well within one-quarter mile: Yes No
Public water supply well within one mile: Yes No

Depth to bottom of fresh water: 200' ✓
Depth to bottom of usable water: 1680' ✓

Surface Pipe by Alternate: 1 2 ✓
Length of Surface Pipe Planned to be set: 220' ✓

Length of Conductor Pipe required: None ✓
Projected Total Depth: 4650' ✓

Producing Formation Target: LKC & Cherokee

Water Source for Drilling Operations:
Well Farm Pond Other

DWR Permit #: _____

(Note: Apply for Permit with DWR)

Will Cores be taken? Yes No

If Yes, proposed zone: _____

Well Drilled For: Oil ✓ Gas OWWO Seismic; # of Holes Other
Well Class: Enh Rec Storage Disposal Other
Well Class: Infield Pool Ext. Wildcat Other
Type Equipment: Mud Rotary Air Rotary Cable

If OWWO: old well information as follows:

Operator: _____
Well Name: _____
Original Completion Date: _____ Original Total Depth: _____

Directional, Deviated or Horizontal wellbore? Yes No

If Yes, true vertical depth: _____

Bottom Hole Location: _____

KCC DKT #: _____

AFFIDAVIT

The undersigned hereby affirms that the drilling, completion and eventual plugging of this well will comply with K.S.A. 55-101, et. seq.
It is agreed that the following minimum requirements will be met:

1. Notify the appropriate district office *prior* to spudding of well;
2. A copy of the approved notice of intent to drill *shall be* posted on each drilling rig;
3. The minimum amount of surface pipe as specified below *shall be set* by circulating cement to the top; in all cases surface pipe *shall be set* through all unconsolidated materials plus a minimum of 20 feet into the underlying formation.
4. If the well is dry hole, an agreement between the operator and the district office on plug length and placement is necessary *prior to plugging*;
5. The appropriate district office will be notified before well is either plugged or production casing is cemented in;
6. If an ALTERNATE II COMPLETION, production pipe shall be cemented from below any usable water to surface within 120 days of spud date. *In all cases, NOTIFY district office* prior to any cementing.

I hereby certify that the statements made herein are true and to the best of my knowledge and belief.

Date: 9 April 2001 Signature of Operator or Agent: [Signature] Title: Agent

RECEIVED
STATE OF KANSAS
CORPORATION COMMISSION

APR 11 2001

04-11-01

CONSERVATION DIVISION
Wichita, Kansas

For KCC Use ONLY

API # 15 - 171-20561-00-00
Conductor pipe required NONE feet
Minimum surface pipe required 220' feet per Alt. ②
Approved by: DPW 4-12-01
This authorization expires: 10-12-01
(This authorization void if drilling not started within 6 months of effective date.)
Spud date: _____ Agent: _____

Remember to:

- File Drill Pit Application (form CDP-1) with Intent to Drill;
- File Completion Form ACO-1 within 120 days of spud date;
- File acreage attribution plat according to field proration orders;
- Notify appropriate district office 48 hours prior to workover or re-entry;
- Submit plugging report (CP-4) after plugging is completed;
- Obtain written approval before disposing or injecting salt water.

31
17
31w

IN ALL CASES PLOT THE INTENDED WELL ON THE PLAT BELOW

Plat of acreage attributable to a well in a prorated or spaced field

If the intended well is in a prorated or spaced field, please fully complete this side of the form. If the intended well is in a prorated or spaced field complete the plat below showing that the well will be properly located in relationship to other wells producing from the common source of supply. Please show all the wells and within 1 mile of the boundaries of the proposed acreage attribution unit for gas wells and within 1/2 mile of the boundaries of the proposed acreage attribution unit for oil wells.

API No. 15 - _____
Operator: WABASH ENERGY CORPORATION
Lease: Strickert
Well Number: 11
Field: Beckley North Ext.
Number of Acres attributable to well: _____
QTR / QTR / QTR of acreage: _____

Location of Well: County: Scott
1369 feet from S / N (circle one) Line of Section
1980 feet from E / W (circle one) Line of Section
Sec. 31 Twp. 17S S. R. 31W East West



Is Section X Regular or _____ Irregular

If Section is Irregular, locate well from nearest corner boundary.

Section corner used: NE NW SE SW

PLAT

*(Show location of the well and shade attributable acreage for prorated or spaced wells.)
(Show footage to the nearest lease or unit boundary line.)*

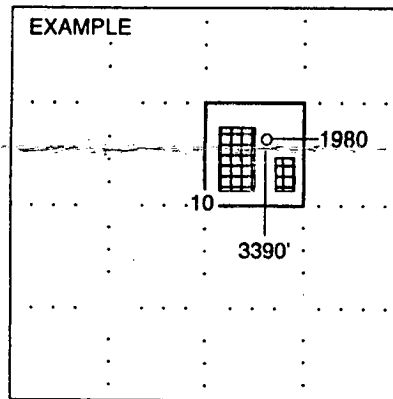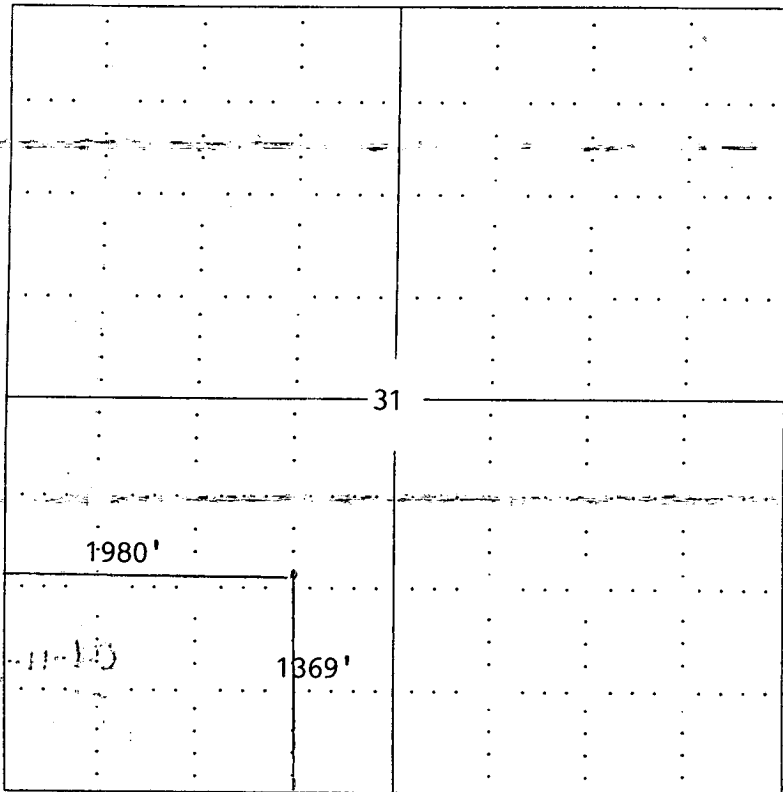

NOTE: In all cases locate the spot of the proposed drilling location.

Scott Co., KS

In plotting the proposed location of the well, you must show:

1. The manner in which you are using the depicted plat by identifying section lines, i.e. 1 section, 1 section with 8 surrounding sections, 4 sections, etc.
2. The distance of the proposed drilling location from the section's south / north and east / west.
3. The distance to the nearest lease or unit boundary line.
4. If proposed location is located within a prorated or spaced field a certificate of acreage attribution plat must be attached: (CO-7 for oil wells; CG-8 for gas wells).