


Give All Information Completely
Make Required Affidavit
Mail or Deliver Report to:
Conservation Division
State Corporation Commission
211 No. Broadway
Wichita, Kansas

WELL PLUGGING RECORD

NORTH

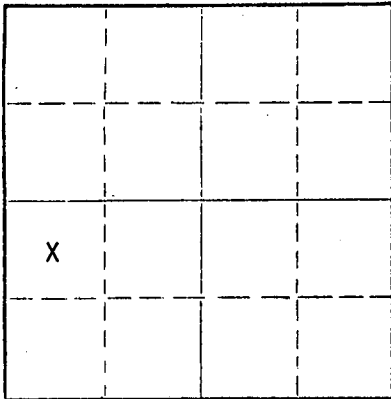

Locate well correctly on above
Section Plat

Hamilton County, Sec. 28 Twp. 25S Rge. 41 (X) (W)
Location as "NE/CNWxSWx4" or footage from lines C NW1/4SW1/4
Lease Owner Armour Properties
Lease Name Bray Well No. 1
Office Address 1107 Oil & Gas Bldg., Wichita Falls, Texas 76301
Character of Well (completed as Oil, Gas or Dry Hole) Dry Hole
Date well completed July 27 19 65
Application for plugging filed July 27 19 65
Application for plugging approved July 27 19 65
Plugging commenced July 27 19 65
Plugging completed July 27 19 65
Reason for abandonment of well or producing formation Dry Hole
If a producing well is abandoned, date of last production 19
Was permission obtained from the Conservation Division or its agents before plugging was commenced? Yes

Name of Conservation Agent who supervised plugging of this well Hugh Scott
Producing formation none Depth to top Bottom Total Depth of Well 5507 Feet
Show depth and thickness of all water, oil and gas formations.

OIL, GAS OR WATER RECORDS

CASING RECORD

FORMATION	CONTENT	FROM	TO	SIZE	PUT IN	PULLED OUT
Surface pipe				8 5/8"	1259'	None

Describe in detail the manner in which the well was plugged, indicating where the mud fluid was placed and the method or methods used in introducing it into the hole. If cement or other plugs were used, state the character of same and depth placed, from feet to feet for each plug set.

Filled hole with heavy mud. Pumped 35 sacks Posmix through open end drill pipe at 700'. Filled hole to X 45', set Howco plug with 15 sacks.

RECEIVED
STATE CORPORATION COMMISSION

AUG 11 1965

CONSERVATION DIVISION
Wichita, Kansas

(If additional description is necessary, use BACK of this sheet)
Name of Plugging Contractor Sterling Drilling Company
Address Box 127, Sterling, Kansas 67579

STATE OF Texas, COUNTY OF Wichita, ss.
A. B. Pullen (employee of owner) or (owner or operator) of the above-described well, being first duly sworn on oath, says: That I have knowledge of the facts, statements, and matters herein contained and the log of the above-described well as filed and that the same are true and correct. So help me God.

(Signature) A. B. Pullen

1107 Oil & Gas Building, Wichita Falls, Texas
(Address)

SUBSCRIBED AND SWORN to before me this 10th day of August, 19 65

My commission expires June 1, 1967

Lydia Gipson
(Lydia Gipson) Notary Public.
Wichita County, Texas

15-075-30032-0000

STERLING DRILLING COMPANY
Sterling, Kansas

WELL LOG - - - - - E. C. Bray #1
LOCATED: C NW SW Section 28-25S-41W, Hamilton County, Kansas

OWNER: Armour Properties
ROTARY DRILLING CONTRACTOR: Group Exploration Company

COMMENCED: July 2, 1965
COMPLETED: July 27, 1965

ROTARY TOTAL DEPTH: 5507'

LOG

0 - 75	Sandy Clay
75 - 100	Sand & Gravel
100 - 300	Clay
300 - 650	Shale & Shells
650 - 1310	Shale & Lime
1310 - 1338	Sand & Shale
1338 - 1450	Salt, Sand & Shale
1450 - 1745	Sand, Shale & Lime
1745 - 2095	Sand & Shale
2095 - 2310	Sand, Shale & Anhydrite
2310 - 2500	Shale
2500 - 2510	Anhydrite
2510 - 2715	Anhydrite, Sand & Lime
2715 - 2890	Shale, Lime & Sand
2890 - 3040	Lime
3040 - 3140	Lime & Shale
3140 - 3180	Lime
3180 - 3495	Lime & Shale
3495 - 3831	Lime
3831 - 3990	Lime & Chalk
3990 - 4446	Lime
4446 - 4497	Lime & Chalk
4497 - 4810	Lime
4810 - 4870	Lime & Shale
4870 - 5014	Lime
5014 - 5212	Lime & Shale
5212 - 5325	Shale
5325 - 5434	Shale, Lime & Sand
5434 - 5507	Lime T.D.

CASING RECORD

Ran 40 joints 24# 1259' of 8-5/8" Casing. Pipe set at 1270' K.B. Cemented with 100 sacks Pozmix, 4% gel; 500 sacks Pozmix, 2% cc.; 150 sacks Pozmix (60-40 no gel) 3% HA-5 on bottom.

RECEIVED
STATE CORPORATION COMMISSION
AUG 11 1965
CONSERVATION DIVISION
Wichita, Kansas

Filled hole with heavy mud. Pumped 35 sacks Pozmix thru open end drill pipe at 700'. Filled hole to 45', set Howco plug with 15 sacks. Complete at 10:00 a.m. Used Howco pump truck. State Plugger: Hugh Scott, Sublette, Kansas.