

STATE OF KANSAS
STATE CORPORATION COMMISSION

Form CP-4

Give All Information Completely
Make Required Affidavit
Mail or Deliver Report to:
Conservation Division
State Corporation Commission
212 No. Market
Wichita, Kansas 67202

WELL PLUGGING RECORD

Hamilton County, Sec. 15 Twp. 25S Rge. (E) 42 (W)

Location as "NE/CNW/SE/SW" or footage from lines 1320' FWL & 1332' FSL

Lease Owner Colorado Interstate Gas Company

Lease Name Cook Well No. 1

Office Address P. O. Box 1087, Colorado Springs, Colorado 80944

Character of Well (completed as Oil, Gas or Dry Hole) Dry hole

Date well completed 3-17 19 73

Application for plugging filed 3-8 19 73

Application for plugging approved 3-12 19 73


Plugging commenced 3-17 19 73

Plugging completed 3-17- 19 73

Reason for abandonment of well or producing formation Dry hole

If a producing well is abandoned, date of last production 19

Was permission obtained from the Conservation Division or its agents before plugging was commenced? Yes

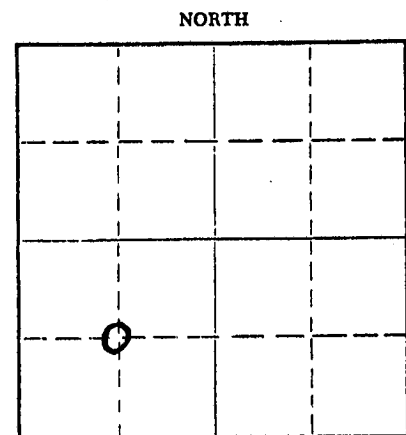

Locate well correctly on above Section Plat

Name of Conservation Agent who supervised plugging of this well Mr. Edgar Eves

Producing formation None Depth to top Bottom Total Depth of Well 3060 Feet

Show depth and thickness of all water, oil and gas formations.

OIL, GAS OR WATER RECORDS

CASING RECORD

| FORMATION | CONTENT | FROM | TO | SIZE | PUT IN | PULLED OUT |
|------------|------------|------|------|--------|--------|------------|
| Krider | Salt water | 2420 | 2468 | 13 3/8 | 132 | None |
| Fort Riley | Salt water | 2576 | 2882 | 8 5/8 | 790 | None |
| | | | | 5 1/2 | 3052 | 1590' |

Describe in detail the manner in which the well was plugged, indicating where the mud fluid was placed and the method or methods used in introducing it into the hole. If cement or other plugs were used, state the character of same and depth placed, from feet to feet for each plug set.

PBTD 3019' GL

3-17-73 Sargent pumped 5 bbls mud w/cottonseed hulls to seal perfs.
25 sx cement from 2425' to 2250'. 70 bbls mud from 2250' to 700'.
35 sx cement from 700' to 600'. 34 bbls mud from 600' to 45'.
15 sx cement from 45' to surface.

Will cut off casing 4' below ground level & weld on steel cap.

RECEIVED
STATE CORPORATION COMMISSION
MAR 29 1973
CONSERVATION DIVISION
Wichita, Kansas

(If additional description is necessary, use BACK of this sheet)

Name of Plugging Contractor Sargents Casing Pulling Service

Address P. O. Box 506, Liberal, Kansas 67901

STATE OF Kansas, COUNTY OF Pottawatomie, ss.

Joseph D. Stewart (employee of owner) or (owner or operator) of the above-described well, being first duly sworn on oath, says: That I have knowledge of the facts, statements, and matters herein contained and the log of the above-described well as filed and that the same are true and correct. So help me God.

(Signature) Joseph D. Stewart, Jr.

(Address)

SUBSCRIBED AND SWORN to before me this 27th day of March, 1973

My commission expires June 1, 1973

Notary Public.

15-075-20049-0000

COLORADO INTERSTATE GAS COMPANY

Cook No. 1 Well
Hamilton County, Kansas

C SW
Sec. 15-25S-42W
Hamilton County, Kans.

RECEIVED
JAN 25 1973
AMARILLO
PRODUCTION

OPERATIONS COMMENCED: 1-10-73

OPERATIONS COMPLETED: 1-17-73

Drillers Log

| | | |
|---------|-------------|---------------|
| 1-10-73 | 0 - 90 | Sand |
| 1-11-73 | 90 - 144 | Sand |
| 1-12-73 | 144 - 748 | Sand & Shale |
| 1-13-73 | 748 - 1302 | Sand & Clay |
| 1-14-73 | 1302 - 2131 | Shale & Anhy. |
| 1-15-73 | 2131 - 2715 | Shale & Anhy. |
| 1-16-73 | 2715 - 2980 | Shale & Lime |
| 1-17-73 | 2980 - 3060 | Lime |

Casing Record

1-12-73 Ran 4 Jts. 13-3/8" 48# casing. Set at 135' G.L. with 250 sacks Class H, 3% CC.

1-13-73 Ran 25 Jts. 8-5/8" 24# casing. Set at 789' with 250 sacks Pozmix, 2% CC, and 150 sacks Class H, 3% CC.

1-17-73 Ran 95 Jts. 5-1/2" 14# casing. Set at 3052' G.L. with 370 sacks 50-50 Pozmix, 10% salt.

RECEIVED
STATE CORPORATION COMMISSION
APR 13 1973
CONSERVATION DIVISION
Wichita, Kansas