


Give All Information Completely  
Make Required Affidavit  
Mail or Deliver Report to:  
Conservation Division  
State Corporation Commission

P. O. Box 17027  
Wichita, Kansas 67217  
NORTH

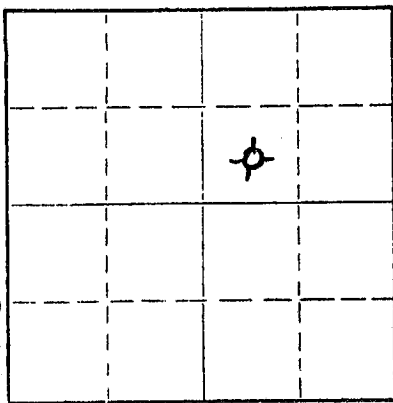

Locate well correctly on above  
Section Plat

WELL PLUGGING RECORD

15-075-20057-0000

Form CP-4

Hamilton County. Sec. 7 Twp. 22S Rge. 42W (E) (W)  
Location as "NE/CNW/SW" or footage from lines C SW NE  
Lease Owner Dare Gas Inc.  
Lease Name Plunkett Well No. 1  
Office Address 544 Liberal, Kansas 67901  
Character of Well (completed as Oil, Gas or Dry Hole) Dry Hole  
Date well completed 7-27 1973  
Application for plugging filed 8-20 1973  
Application for plugging approved 8-29 1973  
Plugging commenced 9-21 1973  
Plugging completed 9-25 1973  
Reason for abandonment of well or producing formation  
no production encountered  
If a producing well is abandoned, date of last production z None 19  
Was permission obtained from the Conservation Division or its agents before plugging was commenced? Yes

Name of Conservation Agent who supervised plugging of this well E. Eves  
Producing formation None Depth to top Bottom Total Depth of Well 2750 Feet  
Show depth and thickness of all water, oil and gas formations.

OIL, GAS OR WATER RECORDS

CASING RECORD

FORMATION	CONTENT	FROM	TO	SIZE	PUT IN	PULLED OUT
Surface	None	0	160	8-5/8	160	None
Permian	None	0	2750	4-1/2	2750	2605'

Describe in detail the manner in which the well was plugged, indicating where the mud fluid was placed and the method or methods used in introducing it into the hole. If cement or other plugs were used, state the character of same and depth placed, from feet to feet for each plug set.

Spot 15 Sacks @ 2525'  
35 Sacks 600' - 500'  
35 Sacks 200' - 100'  
15 Sacks 45' - 0'

RECEIVED  
STATE CORPORATION COMMISSION  
OCT 4 1973  
CONSERVATION DIVISION  
Wichita, Kansas  
10-04-73

(If additional description is necessary, use BACK of this sheet)

Name of Plugging Contractor Sargents Casing Pulling Service  
Address Box 506 Liberal, Kansas 67901 License #511

STATE OF Kansas, COUNTY OF Seward, ss.  
Ralph M. Reynolds (employee of owner) or (owner or operator) of the above-described well, being first duly sworn on oath, says: That I have knowledge of the facts, statements, and matters herein contained and the log of the above-described well as filed and that the same are true and correct. So help me God.

(Signature) Ralph M. Reynolds  
Box 544 - Liberal, Kansas 67901  
(Address)

Subscribed and sworn to before me this 2 day of October 1973

Iris J. Tilley Notary Public  
My commission Expires May 27, 1974

Notary Public.

# DRILLER'S LOG

19-075-20057-0000

LEASE: PLUNKETT #1 LOCATION: C SW NE  
 OWNER: DARE GAS OPERATING, INC. SECTION 7-22S-42W  
 CONT: EARL P. WAKEFIELD, INC. HAMILTON COUNTY, KANSAS  
 CORR: 6-28-73 CASING: 8 5/8" SET @ 160'  
 CONF: 7-2-73 4 1/2" SET @ 2754.13'

Sand	32
Sand & Shale	160
Shale & Sand Stone	1008
Shale & Shells	1510
Shale - Anhydrite	2040
Shale & Lime	2264
Shale & Shells	2484
Lime	2620
Shale & Lime	2678
Lime	2750
P.T.D.	2750

RECEIVED  
 STATE CORPORATION COMMISSION

AUG 29 1973

CONSERVATION DIVISION  
 Wichita, Kansas

STATE OF KANSAS }  
 COUNTY OF SEDGWICK }

ss.

I, Gerald L. Mason, do hereby certify that this is a true and correct log on the Plunkett #1, located C SW NE Section 7-22S-42W, Hamilton County, Kansas, as shown by the daily drilling reports.

EARL P. WAKEFIELD, INC.

BY Gerald L. Mason  
 Gerald L. Mason

Subscribed and sworn to before me this 6th Day of July, 1973.

Commission Expires:  
 October 22, 1976

Carol Jean Noel  
 Carol Jean Noel - Notary Public

