

Give All Information Completely
Make Required Affidavit
Mail or Deliver Report to:
Conservation Division
State Corporation Commission
211 No. Broadway
Wichita, Kansas

WELL PLUGGING RECORD

Hamilton County. Sec. 13 Twp. 22S Rge. 42W (E) (W)

Location as "NE/CNW/SW" or footage from lines Ctr SW NE

Lease Owner Texaco Inc.

Lease Name Blanche Smitherman Unit Well No. 1

Office Address 614 Bitting Bldg., Wichita, Kansas

Character of Well (completed as Oil, Gas or Dry Hole) Dry Hole

Date well completed 11-5 1963

Application for plugging filed 11-6 1963

Application for plugging approved 11-8 1963


Plugging commenced 11-19 1963

Plugging completed 11-19 1963

Reason for abandonment of well or producing formation Dry Hole

If a producing well is abandoned, date of last production Dry Hole 19

Was permission obtained from the Conservation Division or its agents before plugging was commenced? Yes

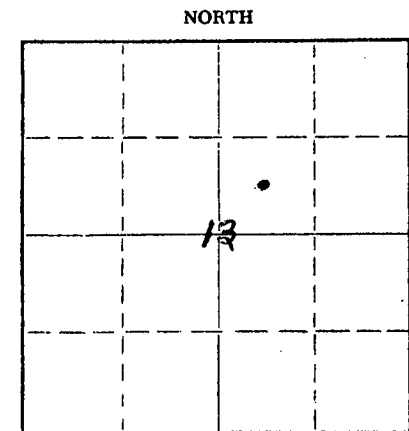

Locate well correctly on above Section Plat

Name of Conservation Agent who supervised plugging of this well Hugh Scott

Producing formation Dry Hole Depth to top Bottom Total Depth of Well 2674 Feet

Show depth and thickness of all water, oil and gas formations.

OIL, GAS OR WATER RECORDS

CASING RECORD

FORMATION	CONTENT	FROM	TO	SIZE	PUT IN	PULLED OUT
Dry Hole				7"	244	None
				4-1/2"	2640	None

Describe in detail the manner in which the well was plugged, indicating where the mud fluid was placed and the method or methods used in introducing it into the hole. If cement or other plugs were used, state the character of same and depth placed, from feet to feet for each plug set.

Hole plugged as follows:- 35 sacks cement 2662' 2340'; heavy mud 2340'-1700'; 15 sacks cement 1700'-1520'; heavy mud, 1520'-400'; 35 sacks cement 400'-surface.

RECEIVED
STATE CORPORATION COMMISSION

DEC 10 1963 12-10-63

CONSERVATION DIVISION
Wichita, Kansas

(If additional description is necessary, use BACK of this sheet)

Name of Plugging Contractor None

Address

STATE OF Kansas, COUNTY OF Sedgwick, ss.

H. N. Wade (employee of owner) or (owner or operator) of the above-described

well, being first duly sworn on oath, says: That I have knowledge of the facts, statements, and matters herein contained and the log of the above-described well as filed and that the same are true and correct. So help me God.

(Signature) [Signature]


614 Bitting Bldg., Wichita, Kansas

(Address)

SUBSCRIBED AND SWORN TO before me this 5th day of December, 1963

[Signature] Notary Public.

My commission expires 6-20-64

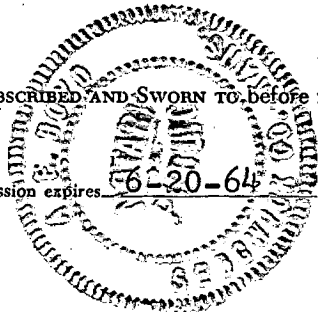

15-075-10122-0000

CONTRACTOR'S WELL LOG

CONTRACTOR:
OWNER:
WELL:
LOCATION:

CHEMICAL & TECHNICAL SERVICES, INC.
TEXACO INC.
BLANCHE SMITHERMAN UNIT #1
SW NE SEC. 13-22S-42W
HAMILTON CO., KANSAS
9/8/63
9/12/63

COMMENCED:
COMPLETED:

0	100	CLAY & POST ROCK
100	145	SAND & POST ROCK
145	244	SHALE
244	785	SHALE & SAND
785	1190	SHALE
1190	1530	SHALE & SALT
1530	1550	ANHYDRITE
1550	1610	SHALE
1610	2030	SHALE & LIME
2030	2238	SHALE & ANHYDRITE
2238	2650	SHALE & LIME
2650		ROTARY TOTAL DEPTH

RECEIVED
STATE CORPORATION COMMISSION

DEC 10 1963

CONSERVATION DIVISION
Wichita, Kansas

SET 7" SURFACE CASING @ 244' W/150 SACKS CEMENT

SET 4-1/2" PRODUCTION CASING @ 2642' W/370 SACKS CEMENT

WE HEREBY CERTIFY THIS TO BE A CORRECT AND ACCURATE LOG OF THE ABOVE DESCRIBED WELL,
AS SHOWN ON THE DAILY DRILLING REPORTS.

CHEMICAL & TECHNICAL SERVICES, INC.

BY: *R. F. McCarty*
ASST. TREASURER

SUBSCRIBED AND SWORN TO BEFORE THIS 16th DAY OF SEPTEMBER, 1963.

Cona Drexler
NOTARY PUBLIC

My Commission Expires January 23, 1964

