


STATE OF KANSAS
STATE CORPORATION COMMISSION

WELL PLUGGING RECORD

Give All Information Completely
Make Required Affidavit
Mail or Deliver Report to
Conservation Division
State Corporation Comm.
245 North Water
Wichita, KS 67202

Hamilton County, Sec. 15 Twp. 21S Rge. 42 NW
Location as "NE/CNW $\frac{1}{4}$ SW $\frac{1}{4}$ " or footage from lines

Lease Owner Kirby Exploration Company
Lease Name Crilliot "A" Well No. 1-15
Office Address P. O. Box 1745, Houston, Texas 77001
Character of Well (Completed as Oil, Gas or Dry Hole)

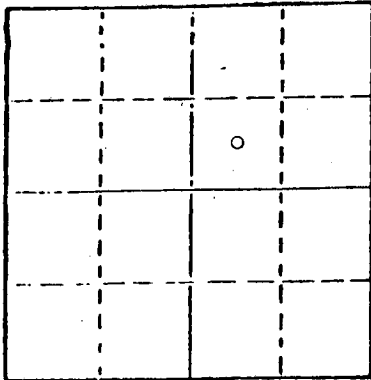

Locate well correctly on above
Section Plat

Dry Hole
Date Well completed September 8 1977
Application for plugging filed September 14 1977
Application for plugging approved September 9 1977
Plugging commenced September 8 1977
Plugging completed September 8 1977
Reason for abandonment of well or producing formation

Dry Hole
If a producing well is abandoned, date of last production 19

Was permission obtained from the Conservation Division or its agents before plugging was commenced? Yes

Name of Conservation Agent who supervised plugging of this well Clarence Thomas
Producing formation - Depth to top - Bottom - Total Depth of Well 3000'
Show depth and thickness of all water, oil and gas formations.

OIL, GAS OR WATER RECORDS

CASING RECORD

FORMATION	CONTENT	FROM	TO	SIZE	PUT IN	PULLED OUT
None	Salt Water			9-5/8"	566'	None
				5-1/2"	3000'	None

Describe in detail the manner in which the well was plugged, indicating where the mud fluid was placed and the method or methods used in introducing it into the hold. If cement or other plugs were used, state the character of same and depth placed, from feet to feet for each plug set. Filled hole with drlg. mud to 2826'. Set a 10 sx. plug from 2745-2826'; filled hole with drlg. mud to 550'. Set 35 sx. cement plug from 250 to 550'. Filled hole with drlg. mud to 40'. Set a 15 sx. cement plug from 40' to surface. Cut off heads 3' below ground level. Welded steel plate on top.


RECEIVED
STATE CORPORATION COMMISSION
OCT 10 1977 10-03-77
CONSERVATION DIVISION
Wichita, Kansas

(If additional description is necessary, use BACK of this sheet)

Name of Plugging Contractor Halliburton Company

STATE OF Texas COUNTY OF Harris, ss.
T. V. McCauley (employee of owner) or (owner or operator)
of the above-described well, being first duly sworn on oath, says: That I have knowledge of the facts, statements, and matters herein contained and the log of the above-described well as filed and that the same are true and correct. So help me God.

(Signature) T. V. McCauley
P. O. Box 1745, Houston, Texas 77001
(Address)

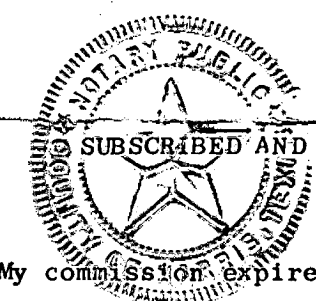

SUBSCRIBED AND SWORN TO before me this 29th day of September, 1977
My commission expires June 30, 1978
Notary Public.

15-075-20174-000 (P)

KANSAS DRILLER'S LOG

LEASE: GRILLIOT A #1-15
OWNER: KIRBY EXPLORATION
CONT: EARL F. WAKEFIELD, INC.
SPUD: 2-19-77
COMP: 2-25-77

LOCATION: SW NE
SECTION 15-21S-42W
HAMILTON COUNTY, KANSAS
CASING: 9 5/8" SET @ 566'
5 1/2" SET @ 3000'

Shale	1275
Lime, Shale & Chalk	1635
Shale & Lime - Anhydrite	1955
Shale & Lime	2200
Shale & Anhydrite	2364
Shale & Lime	2776
Lime & Shale	3000
R.T.D.	3000

STATE OF KANSAS)
) ss.
COUNTY OF SEDGWICK)

I, Gerald L. Mason, do hereby certify that this is a true and correct log on the GRILLIOT A #1-15, located SW NE SECTION 15-21S-42W, HAMILTON COUNTY, KANSAS, as shown by the daily drilling reports.

EARL F. WAKEFIELD, INC.

By: Gerald L. Mason
Gerald L. Mason

03/03/77
C. WAKEFIELD, INC. 15-21S-42W
HAMILTON COUNTY, KANSAS

Subscribed and Sworn to before me this 1st day of March, 1977.

My Appointment Expires:
October 28, 1980

Carol J. Noel
Carol J. Noel -- Notary Public

