

STATE OF KANSAS
STATE CORPORATION COMMISSION

Form CP-4

Give All Information Completely
Make Required Affidavit
Mail or Deliver Report to:
Conservation Division
State Corporation Commission
212 No. Market
Wichita, Kansas 67202

WELL PLUGGING RECORD

Hamilton County, Sec. 12 Twp. 26S Rge. (E) 43 (W)

Location as "NE/CNWxSWx" or footage from lines 1320' FSL & 1320' FWL

Lease Owner Colorado Interstate Gas Company

Lease Name Cornwell Well No. 1

Office Address P. O. Box 1087, Colorado Springs, Colorado 80944

Character of Well (completed as Oil, Gas or Dry Hole) Dry hole

Date well completed 3-18 19 73

Application for plugging filed 3-8 19 73

Application for plugging approved 3-12 19 73


Plugging commenced 3-18 19 73

Plugging completed 3-18- 19 73

Reason for abandonment of well or producing formation Dry hole

If a producing well is abandoned, date of last production 19

Was permission obtained from the Conservation Division or its agents before plugging was commenced? Yes

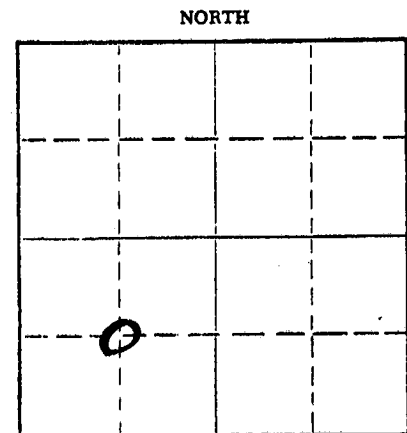

Locate well correctly on above Section Plat

Name of Conservation Agent who supervised plugging of this well Mr. Edgar Eves

Producing formation None Depth to top Bottom Total Depth of Well 2861 Feet

Show depth and thickness of all water, oil and gas formations.

OIL, GAS OR WATER RECORDS

CASING RECORD

FORMATION	CONTENT	FROM	TO	SIZE	PUT IN	PULLED OUT
Tubb	Salt water	1738		8 5/8	787	None
Winfield	Salt water	2269	2683	5 1/2	2831	1000'
Wreford	Salt water	2683	2742			
Council Grove	Salt water	2742	2861			

Describe in detail the manner in which the well was plugged, indicating where the mud fluid was placed and the method or methods used in introducing it into the hole. If cement or other plugs were used, state the character of same and depth placed, from feet to feet for each plug set.

PBTD 2805' GL

3-18-73 Sargent pumped 5 bbls mud w/cotton seed hulls to seal perfs.
25 sx cmt from 1415 to 1240'. 24 bbls mud from 1240' to 700'.
35 sx cmt from 700' to 600'. 34 bbls mud from 600' to 45'.
15 sx cmt from 45' to surface.

Will cut off casing 4' below ground level & weld on steel cap.

RECEIVED
STATE CORPORATION COMMISSION

MAR 29 1973

CONSERVATION DIVISION
Wichita, Kansas

(If additional description is necessary, use BACK of this sheet)

Name of Plugging Contractor Sargents Casing Pulling Service

Address P. O. Box 506, Liberal, Kansas 67901

STATE OF Texas, COUNTY OF Patter, ss.
Joseph D. Stewart (employee of owner) or (owner or operator) of the above-described

well, being first duly sworn on oath, says: That I have knowledge of the facts, statements, and matters herein contained and the log of the above-described well as filed and that the same are true and correct. So help me God.

(Signature) Joseph D. Stewart

(Address) Omaha, Nebraska

SUBSCRIBED AND SWORN to before me this 27th day of March, 1973

My commission expires June 1, 1973

Notary Public.

File -
15-075-20051-0000

COLORADO INTERSTATE GAS COMPANY

C SW
Sec. 12-26S-43W
Hamilton County, Kansas

Cornwell No. 1 Well
Hamilton County, Kansas

OPERATIONS COMMENCED: 1-4-73

OPERATIONS COMPLETED: 1-9-73

Drillers Log

1-4-73	0 - 475	Sand & Clay
1-5-73	475 - 795	Sand & Red Bed
	795 - 1026	Sand
1-6-73	1026 - 1500	Sand & Clay
	1500 - 2036	Shale & Anhy.
	2036 - 2077	Anhy. & Lime
1-7-73	2077 - 2280	Anhy.
	2280 - 2431	Shale & Anhy.
	2431 - 2600	Shale & Lime
1-8-73	2600 - 2730	Shale & Lime
	2730 - 2860	Anhy. & Lime

Casing Record

1-5-73	Ran 25 Jts. 8-5/8" 24# casing. Set at 795' K.B. with 250 sacks 65-35 pozmix, 2% CC, and 150 sacks common, 3% CC.
1-9-73	Ran 88 Jts. 5-1/2" 14# casing. Set at 2831' G.L. with 370 sacks 50-50 pozmix, 10% salt.

RECEIVED
STATE CORPORATION COMMISSION

APR 13 1973

CONSERVATION DIVISION
Wichita, Kansas