


15-169-19032-00-00

STATE OF KANSAS  
STATE CORPORATION COMMISSION  
CONSERVATION DIVISION  
P. O. BOX 17027  
WICHITA, KANSAS 67217

FORM CP-4

WELL PLUGGING RECORD

Saline County, Sec. 20 Twp. 14 Rge. 2 W (E) (W)  
Location as "NE/CNW/SW" or footage from lines NE SW NW  
Lease Owner Art Small & Co.  
Lease Name Burkholder Well No. 1  
Office Address RR#3 E. Country Club Rd. Saline, Kansas 67401  
Character of Well (completed as Oil, Gas or Dry Hole) oil  
Date well completed 12-22-1962  
Application for plugging filed 9-5-1974  
Application for plugging approved 9-6-1974  
Plugging commenced 9-20-1974  
Plugging completed 9-24-1974  
Reason for abandonment of well or producing formation

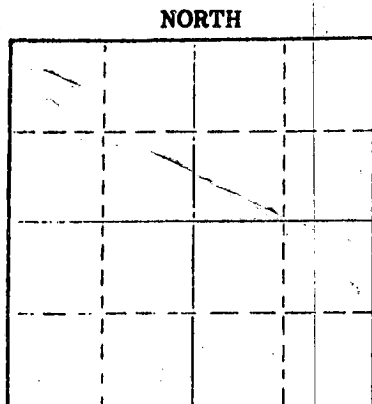

Locate well correctly on above Section Plot

If a producing well is abandoned, date of last production 19  
Was permission obtained from the Conservation Division or its agents before plugging was commenced? yes

Name of Conservation Agent who supervised plugging of this well Hugh Scott  
Producing formation Depth to top Bottom Total Depth of Well 3241'  
Show depth and thickness of all water, oil and gas formations.

OIL, GAS OR WATER RECORDS

CASING RECORD

FORMATION	DATE	FROM	TO	SIZE	PUT IN	PULLED OUT
	RECEIVED					
	STATE CORPORATION COMMISSION			4 1/2"		2,780'
	SEP 30 1974					
	CONSERVATION DIVISION					
	Wichita, Kansas					

Describe in detail the manner in which the well was plugged, indicating where the mud fluid was placed and the method or methods used in introducing it into the hole. If cement or other plugs were used, state the character of same and depth placed, from feet to feet for each plug set.

Plugged off bottom of hole with sand. Sand from 3241' to 3200'. Dumped 4 bx of cement. Mudded hole to 215'. Made 15' of rack bridge. Dumped 3 yds of Ready-Mix cement, filling to the bottom of the collar.

(If additional description is necessary, use BACK of this sheet)

Name of Plugging Contractor Art Lamb Casing Pulling Inc.  
Address 2809 King St. Hutchinson, Kansas 67501

STATE OF Kansas COUNTY OF Reno, ss.  
Art Lamb (employee of owner) or (owner or operator) of the above-described well, being first duly sworn on oath, says: That I have knowledge of the facts, statements, and matters herein contained and the log of the above-described well as filed and that the same are true and correct. So help me God.

(Signature) [Signature]

2809 King St. Hutchinson, Kansas 67501  
(Address)

SUBSCRIBED AND SWORN TO before me this 25th day of September, 1974

My commission expires December 31, 1977

Notary Public.



WELL LOG BUREAU—KANSAS GEOLOGICAL SOCIETY

508 East Murdock,

Wichita, Kansas

COPY


15-169-19032-00-00

Company- DON McKELLAR OIL EXPLORATIONS  
Farm- Burkholder No. 1

SEC. 20 T. 14 R. 2W  
NE SW NW

Total Depth. 3241'  
Comm. 12-14-62 Comp. 12-22-62  
Shot or Treated.  
Contractor. Blackstone Drig., Inc.  
Issued. 4-13-63

County Saline,  
KANSAS

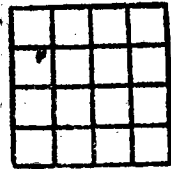

Elevation. 1266' KB

Production. 40 BOPD & 35% WTR.

CASING:

8 5/8" 150' cem w/95 sx.  
4 1/2" 2238' cem w/75 sx.

Figures Indicate Bottom of Formations.

clay	50
sand	65
shale & lime	365
lime	590
lime & shale	780
shale & shells	1150
lime & shale	2205
lime	2335
shale & lime (Mississippi-2650')	2764
Mississippi	2850
chert & lime	2910
lime & shale	3057
lime	3115
lime & shale	3241
Total Depth	
TOPS;	
Mississippi	2650
Kinderhook	2928
Misener	3050
Hunton	3052
Maquoketa Shale	3153
Maquoketa Dolomite	3235

RECEIVED  
STATE CORPORATION COMMISSION  
JUN 7 1974  
CONSERVATION DIVISION  
Wichita, Kansas