


15-169-00705-00-00

WELL PLUGGING RECORD

Give All Information Completely
Make Required Affidavit
Mail or Deliver Report to:
Conservation Division
State Corporation Commission
800 Bitting Building
Wichita, Kansas

Saline County, Sec. 19 Twp. 14 Rge. 2 (E) (W)
Location as "NE/CNW 1/4 SW 1/4" or footage from lines SW NE NW
Lease Owner Caddo Oil Company
Lease Name Becker Well No. 1
Office Address 508 McBirney Bldg. Tulsa, Oklahoma
Character of Well (completed as Oil, Gas or Dry Hole) Dry Hole
Date well completed 12-31-51
Application for plugging filed Verbal request 12-31-19 51
Application for plugging approved January 4, 19 52
Plugging commenced 12-31-51 19
Plugging completed 12-31-51 19
Reason for abandonment of well or producing formation Dry

NORTH

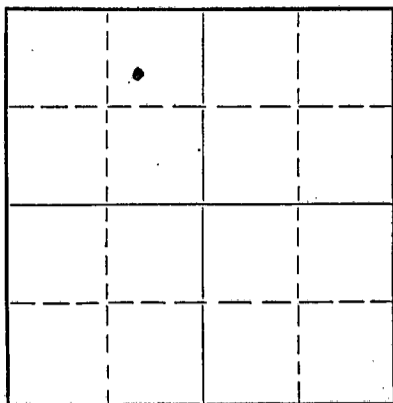

Locate well correctly on above Section Plat

If a producing well is abandoned, date of last production _____ 19____
Was permission obtained from the Conservation Division or its agents before plugging was commenced? _____

Name of Conservation Agent who supervised plugging of this well Mr. Ruel Durkee
Producing formation _____ Depth to top _____ Bottom _____ Total Depth of Well 3320 Feet
Show depth and thickness of all water, oil and gas formations.

OIL, GAS OR WATER RECORDS

CASING RECORD

Formation	Content	From	To	Size	Put In	Pulled Out
<u>Crystalline Viola</u>				<u>8 5/8"</u>	<u>136</u>	

Describe in detail the manner in which the well was plugged, indicating where the mud fluid was placed and the method or methods used in introducing it into the hole. If cement or other plugs were used, state the character of same and depth placed, from _____ feet to _____ feet for each plug set.

of
Filled hole with mud, laid down 1/2" drill pipe
Gunned up pits with drill pipe half way out of hole
and circulated. Set plug at 130 feet and dumped 15 sacks
of cement. Filled hole with mud and 5 sacks of cement
in top of surface pipe.

02-80-52

(If additional description is necessary, use BACK of this sheet)
Name of Plugging Contractor Honaker Drilling Co.
Address Great Bend, Kansas.

STATE OF OKLAHOMA COUNTY OF TULSA, ss.
_____, (employee of owner) or (owner or operator) of the above-described well,
being first duly sworn on oath, says: That I have knowledge of the facts, statements, and matters herein contained and the log of the above-described well as filed and that the same are true and correct. So help me God.

(Signature) Caddo Oil Company - By: M.F. Schuit
508 McBirney Bldg. Tulsa, Oklahoma
(Address)

SUBSCRIBED AND SWORN to before me this 18th day of February, 19 52

Louise Toomey
Notary Public.

My commission expires July 30, 1954

23-8390-s 6-51-20M



PLUGGING
FILE SEC-19-T-14-R-241
PAGE 125 LINE 25

15-169-00705-00-00

DRILLERS LOG

COMPANY: Caddo Oil Company

Sec: 19 T. 14 R. 2

FARM: Becker NO: 1

Loc: SW NE NW

Saline County, Kansas

Total Depth: 3320

Comm: 12-18-51 Comp: 12-31-51

Contractor: Honaker Drilling Co., Inc.

Casing: 8 5/8" 136'

Elevation 1223 D.F.
D & A

70	Sand and Clay	
136	Shale and Shells	8 5/8" Casing Cemented at
190	Lime	136 ft. with 150 sacks.
275	Shale and Gipe	
350	Anhydrite	
460	Broken Anhydrite	
590	Lime and Shale	
760	Shale	
925	Shale and Shells	
1045	Shale, Shells and Salt	
1265	Lime and Shale	
1454	Shale	
1610	Lime and Shale	
1758	Lime	
1865	Lime and Shale	
2070	Lime and Shale	
2170	Shale	
2285	Lime and Shale	
2390	Lime	
2454	Shale and Lime	
2640	Lime and Shale	
2953	Lime	
3045	Shale and Lime	
3084	Shale and Chert	
3179	Shale and Lime	
3224	Shale	
3270	Lime	
3300	Lime and Chert	
3320	Lime	Rotary T.D.


I CERTIFY THAT THIS IS THE TRUE AND CORRECT COPY OF THE ABOVE LOG,
TO THE BEST OF MY KNOWLEDGE.

Joe G. Honaker

Subscribed and sworn to before me this 15 day of January 1951

FEB 20 1952
CONSERVATION DIVISION
WICHITA, KANSAS

Kenneth L. Fischer
Notary Public

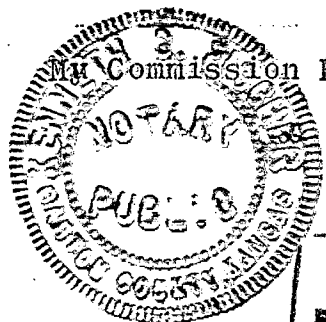

PLUGGING
FILE SEC-19-T-14-R20
BOOK PAGE 135 LINE 25