


Give All Information Completely
Make Required Affidavit
Mail or Deliver Report to:
Conservation Division
State Corporation Commission
800 Bitting Building
Wichita, Kansas

15-169-00779-00-00
WELL PLUGGING RECORD

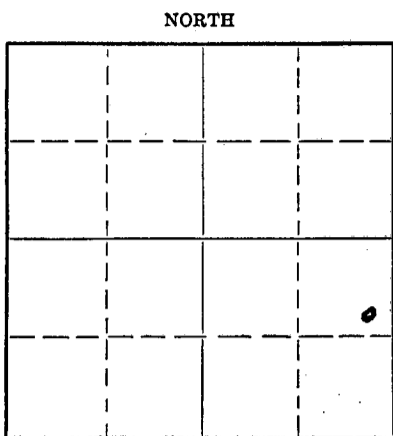

Locate well correctly on above Section Flat

Saline County. Sec. 19 Twp. 14 Rge. (E) 2 (W)
Location as "NE/CNW $\frac{1}{4}$ /SW $\frac{1}{4}$ " or footage from lines CSE NE SE
Lease Owner Claude A. Melvin
Lease Name Melvin Well No. 1
Office Address 645 North Santa Fe, Salina, Kansas
Character of Well (completed as Oil, Gas or Dry Hole) Oil
Date well completed October 27 19 51
Application for plugging filed February 26 19 53
Application for plugging approved 19
Plugging commenced February 26 19 53
Plugging completed February 28 19 53
Reason for abandonment of well or producing formation
Not producing enough
If a producing well is abandoned, date of last production January 20 19 53
Was permission obtained from the Conservation Division or its agents before plugging was commenced? Yes

Name of Conservation Agent who supervised plugging of this well Ruel Durkee, McPherson, Kansas
Producing formation Viola Lime Depth to top 3252 Bottom 3254 Total Depth of Well 3269 Feet
Show depth and thickness of all water, oil and gas formations.

OIL, GAS OR WATER RECORDS

CASING RECORD

Formation	Content	From	To	Size	Put In	Pulled Out
Viola Lime	80% water 20% Oil			8 5/8"	172.17	None
				4 1/2"	3252 1/2	2294

Describe in detail the manner in which the well was plugged, indicating where the mud fluid was placed and the method or methods used in introducing it into the hole. If cement or other plugs were used, state the character of same and depth placed, from _____ feet to _____ feet for each plug set.

Plugged back from 3255' to 3240' with sand, dumped 4 sacks cement at 3240' with dump bailer. Top of cement 3208'. Filled with mud to 175', set rock bridge dumped 15 sacks cement. Top of cement 130', filled with mud to 20', set rock bridge, dumped 5 sacks cement for cap.

(If additional description is necessary, use BACK of this sheet)

Name of Plugging Contractor J-M Casing Pulling Company,
Address Great Bend, Kansas.


STATE OF Kansas COUNTY OF Saline, ss.
Claude A. Melvin (Approves) or (owner) of the above-described well,

being first duly sworn on oath, says: That I have knowledge of the facts, statements, and matters herein contained and the log of the above-described well as filed and that the same are true and correct. So help me God.

(Signature) *Claude A. Melvin*

645 North Santa Fe, Salina, Kansas
(Address)

SUBSCRIBED AND SWORN to before me this 9th day of March, 19 53

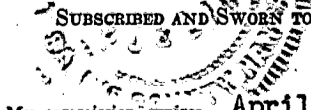

Lawrence T. Wickersham
Notary Public.

My commission expires April 19, 1954.

23-8390-s

6-51-20M

RECEIVED
STATE CORPORATION COMMISSION

MAR 11 1953

CONSERVATION DIVISION
Wichita, Kansas

PLUGGING
FILE SEC 19 T 14 R 2W
BOOK PAGE 82 LINE 24

15-169-00779-00-00


WELL LOG BUREAU--KANSAS GEOLOGICAL SOCIETY
508 East Murdock, Wichita, Kansas

Company- MUSGROVE PETROLEUM CO.
Farm- Melvin No. 1

SEC. 19 T. 14 R. 2W
SE NE SE

Total Depth. 3269
Comm. 10-16-51 Comp. 10-27-51
Shot or Treated.
Contractor. Musgrove Petro.
Issued. 2-2-52

County Saline
KANSAS

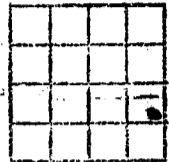

CASING:
8 5/8" 172.17 cem. w/130 sx.
4 1/2" 3252 1/2 cem. w/125 sx.

Elevation. 1270

Production. Pmp 25 bbls.

Figures Indicate Bottom of Formations.

surface sand, shells	105
lime	310
red bed	315
shale & shells	350
lime & shale	910
shale & shells	1635
shale & shells	1830
shale & lime	2324
lime	2332
shale	2365
lime & shale	2625
shale, lime & chert	2705
lime & chert	2749
lime & shale	2775
lime & chert	2865
lime, & chert, shale	2900
lime	2925
lime & shale	2980
shale	3065
lime & shale	3160
shale	3230
shale,	3254
lime	3269
Total Depth	

Tops:	
Mississippi	2653
Kinderhook	2963
Heebner	3056
Mq. shale	3168
Dolo.	3253

R.T.D. 3254
Viola lime at 3252

RECEIVED
STATE CORPORATION COMMISSION
MAR 11 1953
CONSERVATION DIVISION
Wichita, Kansas

PLUGGING
FILE SEC 19 T 14 R 2W
BOOK PAGE 82 LINE 24