


15-169-19037-00-00

STATE OF KANSAS
STATE CORPORATION COMMISSION

Form CP-4

Give All Information Completely
Make Required Affidavit
Mail or Deliver Report to:
Conservation Division
State Corporation Commission
P. O. Box 17027
Wichita, Kansas 67217

WELL PLUGGING RECORD

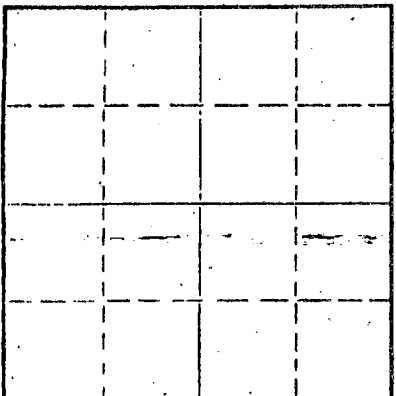

Locate well correctly on above
Section Plat

Saline County. Sec. 17 Twp. 14 Rge. 2W (E) (W)
Location as "NE/CNW/SW" or footage from lines C SE SE
Lease Owner Elderade Supply
Lease Name Gillmore Well No. 2
Office Address 764 Oil Hill Rd. Elderade, Kansas 67042
Character of Well (completed as Oil, Gas or Dry Hole) oil
Date well completed 19
Application for plugging filed Nov 19 73
Application for plugging approved Nov 19 73
Plugging commenced Nov 19 73
Plugging completed Nov 26 19 73
Reason for abandonment of well or producing formation _____

If a producing well is abandoned, date of last production 19
Was permission obtained from the Conservation Division or its agents before plugging was commenced? Yes

Name of Conservation Agent who supervised plugging of this well Gilbert Toman
Producing formation _____ Depth to top _____ Bottom _____ Total Depth of Well 3221' Feet
Show depth and thickness of all water, oil and gas formations.

OIL, GAS OR WATER RECORDS

CASING RECORD

FORMATION	CONTENT	FROM	TO	SIZE	PUT IN	PULLED OUT
				5 1/2"		2,687'

Describe in detail the manner in which the well was plugged, indicating where the mud fluid was placed and the method or methods used in introducing it into the hole. If cement or other plugs were used, state the character of same and depth placed, from _____ feet to _____ feet for each plug set.

Plugged off bottom of hole with sand. Sand from 3221' to 3200'. Dumped 5 sx of cement. Mudded hole to 200'. Made 15' of rock bridge. Dumped 3 Yrds. of Ready-Mix cement, filling to the bottom of the celler.

RECEIVED
STATE CORPORATION COMMISSION
DEC 3 1973
CONSERVATION DIVISION
Wichita, Kansas

(If additional description is necessary, use BACK of this sheet)
Name of Plugging Contractor Art Lamb Casing Pulling Co.
Address 2809 King St. Hutchinson, Kansas 67501


STATE OF Kansas, COUNTY OF Ren, ss.
Art Lamb (employee of owner) or (owner or operator) of the above-described well, being first duly sworn on oath, says: That I have knowledge of the facts, statements, and matters herein contained and the log of the above-described well as filed and that the same are true and correct. So help me God.

(Signature) Art Lamb
2809 King St. Hutchinson, Kansas 67501
(Address)

SUBSCRIBED AND SWORN to before me this 26th day of November, 19 73

My commission expires January 5, 1974

Judy Lamb
Notary Public.

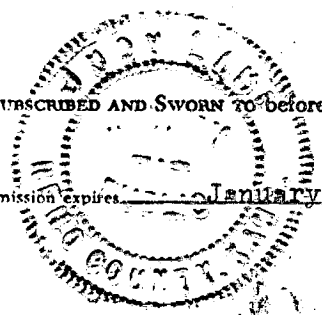

KANSAS GEOLOGICAL SOCIETY

KANSAS WELL LOG BUREAU - KANSAS WELL SAMPLE BUREAU

KANSAS GEOLOGICAL SOCIETY BUILDING

508 EAST MURDOCK - WICHITA, KANSAS

ORIGINAL

STENCILED

OCT 22 1966

COMPANY WALTER J. NELSON

SEC. 17 T. 14 R. 2W

LOC. C SE SE

FARM Gillmore

NO. 2

15-169-19037-00-00

COUNTY Saline

TOTAL DEPTH 3260

COMM. 8-27-63


COMP. 10-17-63

SHOT OR TREATED

CONTRACTOR Clark Knight

ISSUED 10-22-66

KANSAS

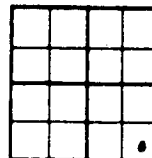

CASING

20	10	
15	8 "	@ 201'
12	6	
13	5"	@ 3259'

ELEVATION 1263'RB

PRODUCTION PMP 30 BOPD

& frac wtr. (Maq Dolo
3212-17)

FIGURES INDICATE BOTTOM OF FORMATIONS

COMPLETE LOG NOT AVAILABLE

Mississippi	2642
Base Mississippi	2879
Hunton	3011
Maquoketa Shale	3119
" Dolomite	3210
Viola	3221 RTD
Total Depth	

RECEIVED
STATE CORPORATION COMMISSION

NOV 16 1973

CONSERVATION DIVISION
Wichita, Kansas