

STATE OF KANSAS
STATE CORPORATION COMMISSION

15-169-00092-00-00


WELL PLUGGING RECORD

Give All Information Completely
Make Required Affidavit
Mail or Deliver Report to:
Conservation Division
State Corporation Commission
800 Bitting Building
Wichita, Kansas

Saline County, Sec. 9 Twp. 14 Rge. 2 (W)

Location as "NE/CNW $\frac{1}{4}$ SW $\frac{1}{4}$ " or footage from lines NE NE SW
Lease Owner Anschutz Drilling Company
Lease Name Roesner Well No. 1
Office Address 709 Union Nat'l Bank Bldg., Wichita, Kansas
Character of Well (completed as Oil, Gas or Dry Hole) Dry Hole
Date well completed December 14 19.51
Application for plugging filed December 14 19.51
Application for plugging approved December 14 19.51
Plugging commenced December 14 19.51
Plugging completed December 14 19.51
Reason for abandonment of well or producing formation Dry Hole

NORTH

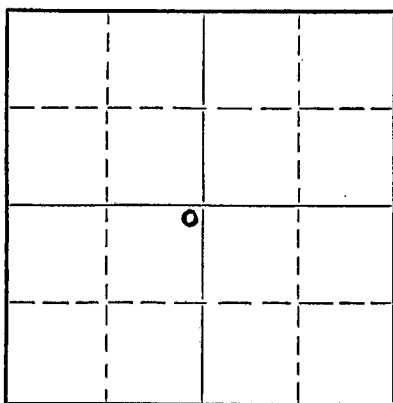

Locate well correctly on above Section Plat

If a producing well is abandoned, date of last production 19...
Was permission obtained from the Conservation Division or its agents before plugging was commenced? Yes

Name of Conservation Agent who supervised plugging of this well Ruel Durkee
Producing formation Depth to top Bottom Total Depth of Well Feet
Show depth and thickness of all water, oil and gas formations.

OIL, GAS OR WATER RECORDS

CASING RECORD

Formation	Content	From	To	Size	Put In	Pulled Out
		surface	165'	8-5/8"		

Describe in detail the manner in which the well was plugged, indicating where the mud fluid was placed and the method or methods used in introducing it into the hole. If cement or other plugs were used, state the character of same and depth placed, from feet to feet for each plug set.

Filled hole half way with heavy mud
Set bottom plug at 160' with 16 sacks cement
Set top plug at 20 feet and filled with 5 sacks cement

RECEIVED
STATE CORPORATION COMMISSION
DEC 27 1951
CONSERVATION DIV
Wichita, Kansas

(If additional description is necessary, use BACK of this sheet)
Correspondence regarding this well should be addressed to Anschutz Drilling Company
Address 709 Union National Bank Building
Wichita, Kansas

STATE OF Kansas, COUNTY OF Sedgwick, ss.
Glenn Ross (employee of owner) or (owner or operator) of the above-described well,
being first duly sworn on oath, says: That I have knowledge of the facts, statements, and matters herein contained and the log of the above-described well as filed and that the same are true and correct. So help me God.

(Signature) Glenn Ross
709 Union National Bank Bldg.
(Address)

SUBSCRIBED AND SWORN to before me this 26th day of December 19 51
May 24, 1952
Wilma V. Shipman
Notary Public.



23-5091-s 8-50-10M
PLUGGING
FILE SEC 9 T 14 R 24
BOOK PAGE 132 LINE 2

15-169-00092-00-00

Company: Anschutz Drilling Company
Farm: Roesner #1

Sec. 9, T 14, R 2
NE NE SW
Saline County, Kansas
Rotary Tools
Elevation: 1227'
Rotary Total Depth: 3373'

Comm: November 29, 1951
Comp: December 14, 1951
Contractor: Penguin Petroleum, Inc.

Casing: 8 5/8" @ 165' cem. w/100 sx.

0-40	Surface dirt & clay
-105	Clay & sand
-130	Shale
-140	Gravel, soft
-175	Lime
-215	Lime & shale
-265	Shale & red bed
-280	Lime
-300	Shale & lime
-335	Lime
-540	Shale & lime
-550	Sandy lime
-640	Sandy shale & lime
-720	Shale
-790	Lime & shale
-830	Sandy shale
-860	Lime & shale
-1285	Shale & shells
-1400	Shale
-1440	Lime & shale
-1885	Shale & lime
-1950	Shale
-2032	Lime & shale
-2487	Shale & lime
-2590	Shale
-2645	Dolomite
-2693	Cherty lime
-2745	Lime Broken & cherty
-2832	Lime
-2930	Shale & lime
-2955	Shale
-2973	Sand & lime
-3090	Lime
-3165	Shale
-3195	Lime
-3231	Lime, little chert
-3291	Lime
-3297	Coreing
-3373	Lime

R.T.D. 3373'

Tops:	Kansas City	1950'
	Mississippi	2595'
	Kinderhook	2830'
	Misener	2955'
	Hunton	2957'
	Maquoketa shale	3082'
	Maquoketa dolomite	3165'
	Viola	3191'
	Simpson shale	3286'
	Simpson sand	3283'
	Arbuckle	3365'

RECEIVED
STATE CORPORATION COMMISSION
DEC 27 1951
CONSERVATION DIVISION
Wichita, Kansas

Drill Stem Test #1 @ 2973' - Recovery 5' Rotary mud. BHP 700#
Drill Stem Test #2 @ 3172' - Recovery 7' Rotary mud. BHP 960#
Drill Stem Test #3 @ 3286'-3297' - Recovery 8' muddy fresh water. BHP 1030#

PLUGGING
FILE SEC 9 T 14 R 22
BOOK PAGE 137 LINE 2

Certified to be a true copy of the well log as indicated on daily drilling reports.

PENGUIN PETROLEUM, INC.

By Don Melland

Subscribed and sworn to before me, the undersigned, a Notary Public in and for Sedgwick County, Kansas, this 18th day of December, 1951.

My Commission Expires:

October 13, 1952

L. D. Sinclair

Notary Public

RECEIVED
STATE CORPORATION COMMISSION
DEC 27 1951
CONSERVATION DIVISION
Wichita, Kansas